

MISSISSIPPI DEPARTMENT OF NATURAL RESOURCES
Bureau of Land and Water Resources
 Southport Mall
 P.O. Box 10631
 Jackson, Mississippi 39209
WATER WELL DRILLERS LOG

3

Washington
D 1033

10-2 1982 Schultz Drilling Washington
 date well completed firm name county well located

LANDOWNER: WA Ross
 1243 KIRK DR
 Greenville MS
 (mailing address)

description of formations encountered	from	to
	clay	0
sand	20	40
coarse sand	40	80

WELL LOCATION:
 sec. 22 T 18 N R 8 E
 S W
 4.2 miles (distance) N (direction) of Memphis (nearest town)

WELL PURPOSE:
 (home, irrigation, municipal, industrial)

- WELL COMPLETION DATA:
- (1) diameter (inches) 2"
 - (2) total depth (feet) 80'
 - (3) static water level (feet) 17' ^{below} top of ground.
 - (4) casing: PVC (material), 70' (depth)
 2" (size) if telescope see back.
 - (5) screen 10' (length), 70' (depth to top)
 2" (size), PVC (material)
 - (6) pump 1 (HP), 10 (yield gpm)
 elec (type power)
 - (7) electric log no (yes or no)
 (organization running log)
 - (8) how well bottom plugged

DRILLERS REMARKS:


DEPT. OF NATURAL RESOURCES
 BUREAU OF LAND & WATER RESOURCES

JUN - 8 1982

RECEIVED

If well telescopes please sketch and show depths.

GROUND LEVEL

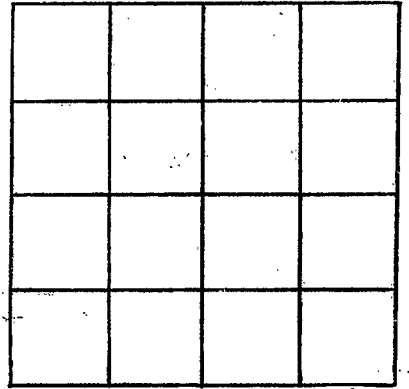

SECTION _____

Please indicate well location X.

ADDITIONAL INFORMATION

If more than one screen,
show locations of each on sketch.