

Washington
D D

MISSISSIPPI
BOARD OF WATER COMMISSIONERS
1034 416 North State Street
Jackson, Mississippi 39201

WATER WELL DRILLERS LOG

10-28 1983 Schultz Drilling Washington
date well completed firm name county well located

LANDOWNER:
Reeves Transportation
Greenville, MS
(mailing address)

description of formations encountered	from	to
Topsoil	0	35
COARSE SAND + pea gravel	35	90
SANDY SHALE	160	340
Med. SAND	340	380
good SAND	380	430

WELL LOCATION:
sec. 15 T. 18 N R. 8 E
2 miles E of Greenville
(distance) (direction) (nearest town)

WELL PURPOSE: INDUSTRIAL
(home, irrigation, municipal, industrial)

WELL COMPLETION DATA:

(1) diameter (inches) 4" x 2"

(2) total depth (feet) 430'

(3) static water level (feet) 32' below top of ground.

(4) casing PVC 410'
(material) (depth)

(size) If telescope see back.

(5) screen 20' 410'
(length) (depth to top)

2" PVC
(size) (material)

(6) pump 1 hp 19 gpm
(HP) (yield gpm)

elb
(type power)

(7) electric log NO
(yes or no)

(organization running log)

(8) how well bottom plugged b/w



DRILLERS REMARKS:

DEPT. OF NATURAL RESOURCES
BUREAU OF LAND & WATER RESOURCES

NOV 14 1983

RECEIVED

If well telescopes please sketch and show depths.

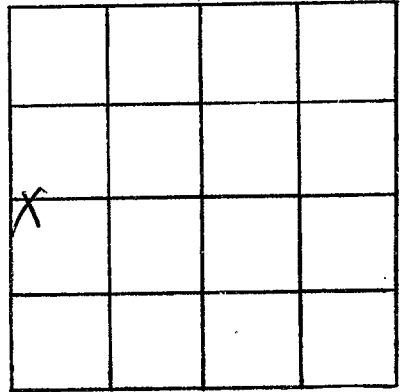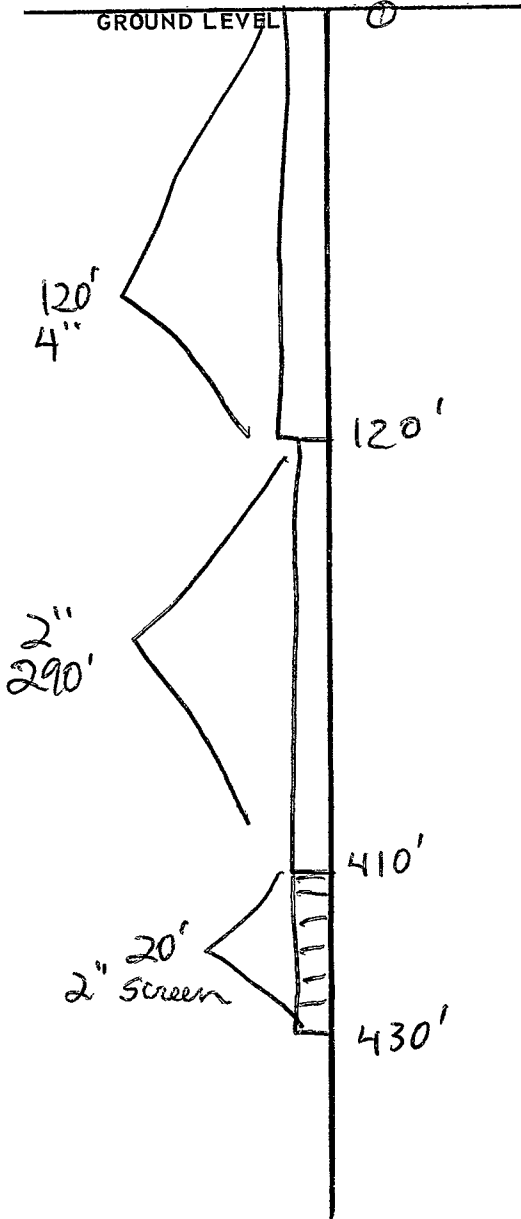

SECTION 15

Please indicate well location X.

ADDITIONAL INFORMATION

If more than one screen, show locations of each on sketch.