

MISSISSIPPI DEPARTMENT OF NATURAL RESOURCES

Bureau of Land and Water Resources

Southport Mall

P.O. Box 10631

Jackson, Mississippi 39209

WATER WELL DRILLERS LOG

Washington
D 1035

30 Aug 1983 Lambert Drilling Wash
date well completed firm name county well located

LANDOWNER:	description of formations encountered	from	to
<u>Billy Reeves,</u> <u>Hwy 1 N. Greenville</u> (mailing address)			
WELL LOCATION:	<u>Sand</u>	<u>25</u>	<u>70</u>
sec. <u>32</u> T. <u>18</u> N. R. <u>8</u> E <u>4</u> miles <u>N</u> of <u>Greenville</u> (distance) (direction) (nearest town)	<u>Pea gravel</u>	<u>70</u>	<u>116</u>
WELL PURPOSE: <u>none</u> (home, irrigation, municipal, industrial)	<u>Clay</u>	<u>116</u>	<u>210</u>
WELL COMPLETION DATA:	<u>Clay st. Sand.</u>	<u>210</u>	<u>430</u>
(1) diameter (inches) <u>4x2</u>	<u>Sand, fine</u>	<u>430</u>	<u>570</u>
(2) total depth (feet) <u>545</u>	<u>Sand.</u>	<u>570</u>	<u>545</u>
(3) static water level (feet) <u>68</u> below above top of ground.			
(4) casing <u>PVC</u> , <u>525</u> (material) (depth) <u>4x2</u> If telescope see back. (size)			
(5) screen <u>20</u> , <u>525-545</u> (length) (depth to top) <u>2</u> , <u>PVC</u> (size) (material)			
(6) pump <u>1</u> , <u>20</u> (HP) (yield gpm) <u>elect</u> (type power)			
(7) electric log _____ (yes or no) _____ (organization running log)			
(8) how well bottom plugged _____ <u>back press.</u>			
DRILLERS REMARKS: _____			

DEPT. OF NATURAL RESOURCES
BUREAU OF LAND & WATER RESOURCES

NOV 29 1983

RECEIVED

If well telescopes please sketch and show depths.

GROUND LEVEL

140


4"

525

2"

545

2" SCH

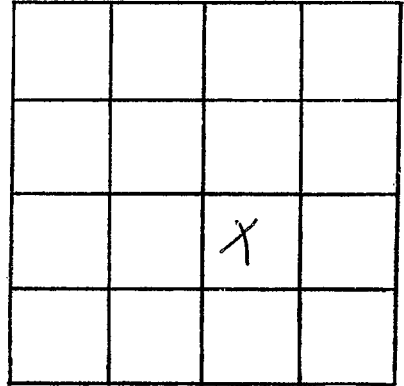

SECTION 32

Please indicate well location X.

ADDITIONAL INFORMATION

If more than one screen,
show locations of each on sketch.