

MISSISSIPPI DEPARTMENT OF NATURAL RESOURCES

Bureau of Land and Water Resources

Southport Mall

P.O. Box 10631

Jackson, Mississippi 39209

WATER WELL DRILLERS LOG

Washington
D 1036

10 Sept 1983 date well completed Lambert Drilling firm name Wash county well located

| LANDOWNER: | description of formations encountered | from | to |
|---|---------------------------------------|------|----|
| Barton Construction Memphis, Tenn. (mailing address) | mixed | 0 | 15 |
| WELL LOCATION: sec. 21 T. 18 N. R. 8 E 1 miles S of Greenville (distance) (direction) (nearest town) | Clay | 15 | 30 |
| WELL PURPOSE: industrial (home, irrigation, municipal, industrial) | Sand | 30 | 70 |
| WELL COMPLETION DATA: | fine gravel | 70 | 94 |
| (1) diameter (inches) 8" | | | |
| (2) total depth (feet) 94 | | | |
| (3) static water level (feet) 56 below top of ground. | | | |
| (4) casing PVC 74 (material) (depth) | | | |
| (size) if telescope see back. | | | |
| (5) screen 20 94-74 (length) (depth to top) | | | |
| 8" PVC (size) (material) | | | |
| (6) pump 10 300 (HP) (yield gpm) | | | |
| elect (type power) | | | |
| (7) electric log (yes or no) | | | |
| (organization running log) | | | |
| (8) how well bottom plugged cap | | | |
| DRILLERS REMARKS: | | | |


DEPT. OF NATURAL RESOURCES
BUREAU OF LAND & WATER RESOURCES

NOV 23 1983

RECEIVED

If well telescopes please sketch and show depths.

GROUND LEVEL

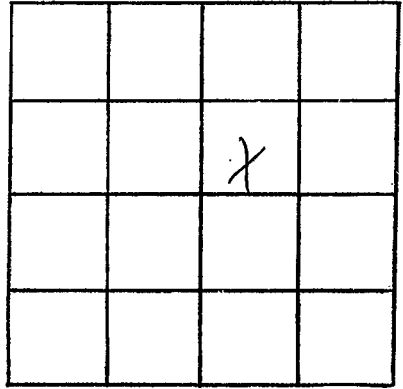

SECTION 21

Please indicate well location X.

ADDITIONAL INFORMATION

If more than one screen,
show locations of each on sketch.