

MISSISSIPPI DEPARTMENT OF NATURAL RESOURCES

Bureau of Land and Water Resources

Southport Mall

P.O. Box 10631

Jackson, Mississippi 39209

WATER WELL DRILLERS LOG

Washington  
D 1037

14 Oct 83, 19 Lambert Drilling Wash  
date well completed firm name county well located

LANDOWNER:	description of formations encountered	from	to
Bob's Fishery Dock			
Lake Ferguson Greenville (mailing address)	Mixed	0	15
WELL LOCATION:	Gravel	15	65
sec 32 T 18 N R 8 E S 8 W	pea gravel	65	105
4 miles N of Greenville (distance) (direction) (nearest town)	Clay	105	310
WELL PURPOSE: <del>private</del> <del>residential</del> (home, irrigation, municipal, industrial)	Clay & Sand	310	460
WELL COMPLETION DATA:	Sand	460	490
(1) diameter (inches) 4x2			
(2) total depth (feet) 490			
(3) static water level (feet) 76 below top of ground. above			
(4) casing PVC, 470 (material) (depth) 4x2 (size) If telescope see back.			
(5) screen 20, 490-470 (length) (depth to top) 2 (size) PVC (material)			
(6) pump 1, 20 (HP) (yield gpm) eject (type power)			
(7) electric log (yes or no)			
(organization running log)			
(8) how well bottom plugged back fill			
DRILLERS REMARKS:			

DEPT. OF NATURAL RESOURCES  
BUREAU OF LAND & WATER RESOURCES

NOV 29 1983

RECEIVED

If well telescopes please sketch and show depths.


GROUND LEVEL

140 4"



470 2"

490 2' 50"

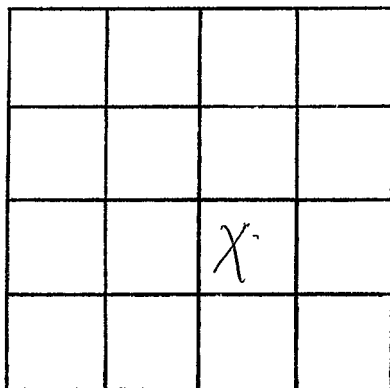

SECTION 32

Please indicate well location X.

ADDITIONAL INFORMATION

If more than one screen,  
show locations of each on sketch.