

MISSISSIPPI DEPARTMENT OF NATURAL RESOURCES

Bureau of Land and Water Resources

Southport Mall

P.O. Box 10631

Jackson, Mississippi 39209

WATER WELL DRILLERS LOG

Washington  
D 1038

25 Oct 83 19 Lambert Drilling Wash  
 date well completed firm name county well located

LANDOWNER:	description of formations encountered	from	to
<u>Roy Jordan</u>			
<u>Walter Lovason, Greenville</u> (mailing address)	<u>mixed</u>	<u>0</u>	<u>15</u>
<b>WELL LOCATION:</b>	<u>Clay</u>	<u>15</u>	<u>38</u>
sec. <u>32</u> T. <u>18</u> N. R. <u>8</u> E	<u>Sand</u>	<u>38</u>	<u>65</u>
<u>4</u> miles <u>N</u> of <u>Greenville</u>	<u>pea gravel</u>	<u>65</u>	<u>100</u>
(distance) (direction) (nearest town)	<u>Clay &amp; Sand</u>	<u>100</u>	<u>210</u>
<b>WELL PURPOSE:</b> <u>Water</u> (home, irrigation, municipal, industrial)	<u>Sand medi</u>	<u>210</u>	<u>405</u>
<b>WELL COMPLETION DATA:</b>	<u>Sand</u>	<u>405</u>	<u>500</u>
(1) diameter (inches) <u>4 1/2</u>			
(2) total depth (feet) <u>500</u>			
(3) static water level (feet) <u>76</u> below top of ground.			
(4) casing <u>PVC</u> , <u>480</u> , (material) (depth)			
<u>4 1/2</u> If telescope see back. (size)			
(5) screen <u>20</u> , <u>500-480</u> (length) (depth to top)			
<u>2</u> , <u>PVC</u> (size) (material)			
(6) pump <u>1</u> , <u>20</u> (HP) (yield gpm)			
<u>elect</u> (type power)			
(7) electric log <u>no</u> (yes or no)			
(organization running log)			
(8) how well bottom plugged: <u>back. WEST</u>			
DRILLERS REMARKS:			

DEPT. OF NATURAL RESOURCES  
 BUREAU OF LAND & WATER RESOURCES

NOV 29 1983

RECEIVED


If well telescopes please sketch and show depths.

GROUND LEVEL

140 4"

480 2"

500 2" screen

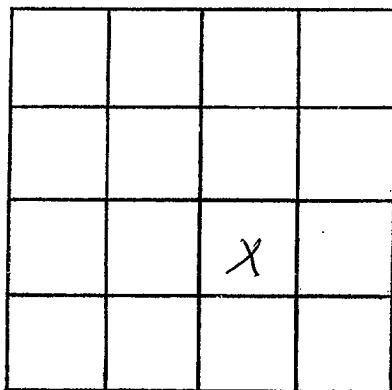

SECTION 32

Please indicate well location X.

ADDITIONAL INFORMATION

If more than one screen,  
show locations of each on sketch.