

Washington
 D 1040

MISSISSIPPI DEPARTMENT OF NATURAL RESOURCES
 Bureau of Land and Water Resources
 Southport Mall
 P.O. Box 10631
 Jackson, Mississippi 39209
WATER WELL DRILLERS LOG

15 Feb 84 19 Lambert Drilling Wash
 date well completed firm name county well located

LANDOWNER:	description of formations encountered	from	to
<u>Heik-Kremer</u>			
<u>Lake Ferguson - Greenville</u> (mailing address)	<u>Mixed</u>	<u>0</u>	<u>20</u>
WELL LOCATION: sec. <u>32</u> T. <u>18</u> N. R. <u>8</u> E <u>3</u> miles <u>N</u> of <u>Greenville</u> (distance) (direction) (nearest town)	<u>sand</u>	<u>20</u>	<u>65</u>
WELL PURPOSE: <u>none</u> (home, irrigation, municipal, industrial)	<u>Sand & gravel</u>	<u>65</u>	<u>110</u>
WELL COMPLETION DATA:	<u>Clay</u>	<u>110</u>	<u>142</u>
(1) diameter (inches) <u>4x2</u>	<u>rock</u>	<u>142</u>	<u>143</u>
(2) total depth (feet) <u>445</u>	<u>Clay</u>	<u>143</u>	<u>280</u>
(3) static water level (feet) <u>65</u> below top of ground.	<u>sand & clay st</u>	<u>280</u>	<u>390</u>
(4) casing <u>PVC</u> , <u>415</u> , (material) (depth) <u>4x2</u> if telescope see back. (size)	<u>Sand</u>	<u>390</u>	<u>445</u>
(5) screen <u>30</u> , <u>445-415</u> (length) (depth to top)			
(6) pump <u>1 1/2</u> , <u>PVC</u> , (HP) (material) <u>elect</u> (type power)			
(7) electric log <u>no</u> (yes or no)			
(organization running log)			
(8) how well bottom plugged <u>back 1/255</u>			
DRILLERS REMARKS:			

DEPT. OF NATURAL RESOURCES
 BUREAU OF LAND & WATER RESOURCES

MAR 22 1984

RECEIVED


If well telescopes please sketch and show depths.

GROUND LEVEL

140 4' 11"

415 2' 11"

445 2' 5" cv.

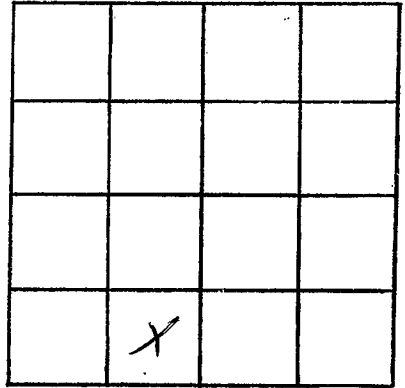

SECTION 32

Please indicate well location X.

ADDITIONAL INFORMATION

If more than one screen, show locations of each on sketch.