

MISSISSIPPI DEPARTMENT OF NATURAL RESOURCES

Bureau of Land and Water Resources

Southport Mall

P.O. Box 10631

Jackson, Mississippi 39209

WATER WELL DRILLERS LOG

Washington
D1042

12/13/83
date well completed

Coppage Drilling & Wash
firm name

county well located

LANDOWNER:

Eden Smith

description of formations encountered

from

to

RT 1 Box 554-E

Leland Ms

(mailing address)

<u>CLAY</u>	<u>0</u>	<u>20</u>
<u>SAND</u>	<u>20</u>	<u>40</u>
<u>GRAVEL & Sand</u>	<u>40</u>	<u>80</u>
<u>GRAVEL</u>	<u>80</u>	<u>100</u>
<u>CLAY</u>	<u>100</u>	<u>340</u>
<u>Rock</u>	<u>340</u>	<u>340</u>
<u>CLAY</u>	<u>340</u>	<u>440</u>
<u>SAND</u>	<u>440</u>	<u>480</u>

WELL LOCATION:

sec 21 T 18 N R 8 E
S 1 miles (distance) SE (direction) of GREENWILL (nearest town)

WELL PURPOSE:

Domestic
(home, irrigation, municipal, industrial)

WELL COMPLETION DATA:

- (1) diameter (inches) 4x2
- (2) total depth (feet) 480
- (3) static water level (feet) 48 below above top of ground.
- (4) casing POC 470
(material) (depth)
4x2 if telescope see back.
(size)
- (5) screen 10 460
(length) (depth to top)
2" POC
(size) (material)
- (6) pump 1 19
(HP) (yield gpm)
Electric
(type power)
- (7) electric log No
(yes or no)

(organization running log)

(8) how well bottom plugged Back Wash Valve

DRILLERS REMARKS:


DEPT. OF NATURAL RESOURCES
BUREAU OF LAND & WATER RESOURCES

SEP 13 1984

RECEIVED

If well telescopes please sketch and show depths.

GROUND LEVEL

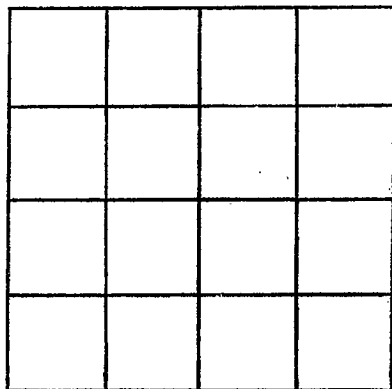

SECTION _____

Please indicate well location X.

ADDITIONAL INFORMATION

If more than one screen,
show locations of each on sketch.