

**MISSISSIPPI DEPARTMENT OF NATURAL RESOURCES**  
**Bureau of Land and Water Resources**  
 Southport Mall  
 P.O. Box 10631  
 Jackson, Mississippi 39209  
**WATER WELL DRILLERS LOG**

Washington  
D 1043

2/21 date well completed      W. Cappage Drilling Wash firm name      Wash county well located

LANDOWNER: Max Phillips  
RT 1 Box 227  
GREENVILLE Ms  
 (mailing address)

WELL LOCATION:  
 sec 34 T 18 N R 8 E  
2 miles N of GREENVILLE  
 (distance) (direction) (nearest town)

WELL PURPOSE:  
 (home, irrigation, municipal, industrial)

WELL COMPLETION DATA:

(1) diameter (inches) 4x2

(2) total depth (feet) 530

(3) static water level (feet) 39 below above top of ground.

(4) casing PVC 530 (material) (depth)  
4x2 (size) if telescope see back.

(5) screen 10 520 (length) (depth to top)  
2" PVC (size) (material)

(6) pump 1 19 (HP) (yield gpm)  
Electric (type power)

(7) electric log No (yes or no)

(organization running log)

description of formations encountered	from	to
CLAY	0	40
SAND	40	68
GRAVEL	68	100
CLAY	100	310
SAND	310	400
CLAY	400	440
Loch	440	
CLAY	440	500
SAND	500	540

(8) how well bottom plugged Jack wash valve

DRILLERS REMARKS:


DEPT. OF NATURAL RESOURCES  
 BUREAU OF LAND & WATER RESOURCES

SEP 13 1984

**RECEIVED**

If well telescopes please sketch and show depths.

GROUND LEVEL

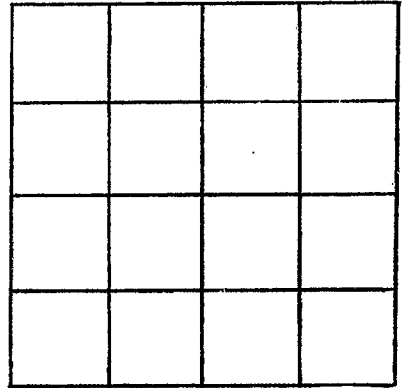

SECTION \_\_\_\_\_

Please indicate well location X.

ADDITIONAL INFORMATION

If more than one screen, show locations of each on sketch.