

MISSISSIPPI DEPARTMENT OF NATURAL RESOURCES

Bureau of Land and Water Resources

Southport Mall

P.O. Box 10631

Jackson, Mississippi 39209

WATER WELL DRILLERS LOG

Washington
D 1045

7/20
date well completed

McCoy Drilling
firm name

Wash.
county well located

LANDOWNERS: Dr. Robert Brown

description of formations encountered

from

to

1705 Hospital
Greenville Ms.
(mailing) address

Clay	0	40
SAND	40	60
SAND + GRAVEL	60	100
GRAVEL	100	110
Clay	110	300
Lignite	300	
Clay	300	400
Rock	400	
Clay	400	460
SAND	460	540

WELL LOCATION:

sec 35 T 18 N R 8 E
S S
4 miles S of Greenville
(distance) (direction) (nearest town)

WELL PURPOSE: Home
(home, irrigation, municipal, industrial)

WELL COMPLETION DATA:

- (1) diameter (inches) 4x3
- (2) total depth (feet) 530
- (3) static water level (feet) 47 below above top of ground.
- (4) casing PVC 530
(material) (depth)
- 4x3 if telescope see back.
(size)
- (5) screen 15
(length) (depth to top)
- 3" PVC
(size) (material)
- (6) pump 3 55
(HP) (yield gpm)
- Electric
(type power)
- (7) electric log N
(yes or no)
- (organization running log)

(8) how well bottom plugged stack wash valve

DRILLERS REMARKS:


DEPT. OF NATURAL RESOURCES
BUREAU OF LAND & WATER RESOURCES

SEP 13 1984

RECEIVED

If well telescopes please sketch and show depths.

GROUND LEVEL

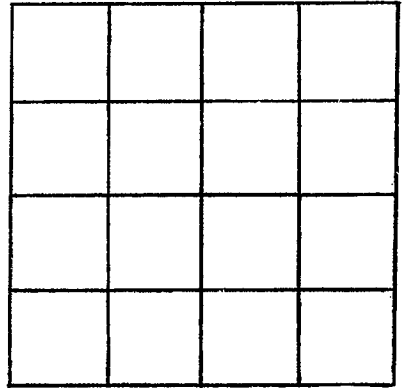

SECTION _____

Please indicate well location X.

ADDITIONAL INFORMATION

If more than one screen,
show locations of each on sketch.