

Washington
D 1046

MISSISSIPPI DEPARTMENT OF NATURAL RESOURCES
Bureau of Land and Water Resources
Southport Mall
P.O. Box 10631
Jackson, Mississippi 39209
WATER WELL DRILLERS LOG

7-11 1984 Schultz Drilling Washington
date well completed firm name county well located

| LANDOWNER: | description of formations encountered | from | to |
|--|---------------------------------------|------|----|
| Louis Alexander | CLAY | 0 | 21 |
| Greenville, MS | MED SAND | 21 | 40 |
| (mailing address) | COARSE SAND | 40 | 75 |
| WELL LOCATION: | | | |
| sec 26 T 18 N R 8 E S W | | | |
| 2 miles E of Greenville (distance) (direction) (nearest town) | | | |
| WELL PURPOSE: IRRIGATION (home, irrigation, municipal, industrial) | | | |
| WELL COMPLETION DATA: | | | |
| (1) diameter (inches) 2" | | | |
| (2) total depth (feet) 75' | | | |
| (3) static water level (feet) 28' below top of ground. | | | |
| (4) casing PVC, 70' (material) (depth) | | | |
| (size) if telescope see back. | | | |
| (5) screen 5', 70' (length) (depth to top) | | | |
| 2" PVC (size) (material) | | | |
| (6) pump 1, 10 (HP) (yield gpm) | | | |
| ele (type power) | | | |
| (7) electric log NO (yes or no) | | | |
| (organization running log) | | | |
| (8) how well bottom plugged PVC CAP | | | |
| DRILLERS REMARKS: | | | |


DEPT. OF NATURAL RESOURCES
BUREAU OF LAND & WATER RESOURCES

NOV 26 1984

RECEIVED

If well telescopes please sketch and show depths.

GROUND LEVEL

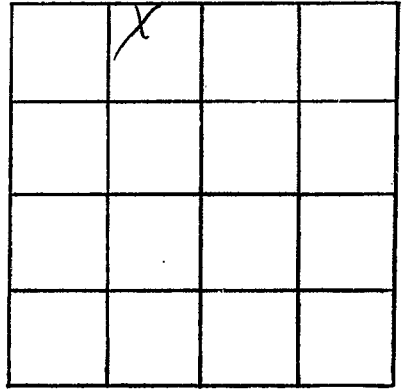

SECTION 20

Please indicate well location X.

ADDITIONAL INFORMATION

If more than one screen,
show locations of each on sketch.