

Washington
 D 1048
 3/12/80

MISSISSIPPI
 BOARD OF WATER COMMISSIONERS
 416 North State Street
 Jackson, Mississippi 39201

WATER WELL DRILLERS LOG

12 mar 1980 Lambort Drilling Wash
 date well completed firm name county well located

LANDOWNER:	description of formations encountered	from	to
James Steinhouser			
Greenville (mailing address)	Sand	24	91
WELL LOCATION: sec. 15 T18 N R 8 E 8 S W 4 miles E of Greenville (distance) (direction) (nearest town)	blue Shell	91	150
WELL PURPOSE: home (home, irrigation, municipal, industrial)	Clay st Sand	150	200
WELL COMPLETION DATA: (1) diameter (inches) 2	Sand tight	200	340
(2) total depth (feet) 490	Sand good	340	375
(3) static water level (feet) 89 below top of ground.	Sand st	375	405
(4) casing PVC 480 (material) (depth)	Sand gravel	405	435
(size) if telescope see back.	Sand good	435	490
(5) screen 10 490-480 (length) (depth to top)			
2" PVC (size) (material)			
(6) pump 1 7 (HP) (yield gpm)			
elect (type power)			
(7) electric log (yes or no)			
(organization running log)			
(8) how well bottom plugged back press			
DRILLERS REMARKS:			


DEPT. OF NATURAL RESOURCES
 BUREAU OF LAND & WATER RESOURCES

MAY 29 1980

RECEIVED

If well telescopes please sketch and show depths.

GROUND LEVEL

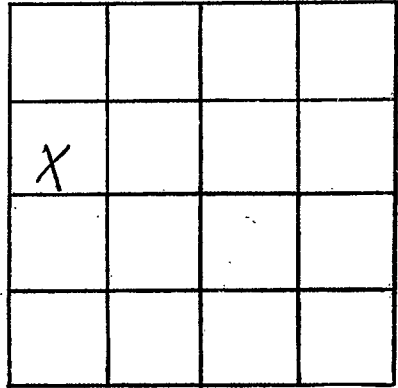

SECTION 15

Please indicate well location X.

ADDITIONAL INFORMATION

If more than one screen,
show locations of each on sketch.