

MISSISSIPPI DEPARTMENT OF NATURAL RESOURCES

Bureau of Land and Water Resources

Southport Mall

P.O. Box 10631

Jackson, Mississippi 39209

WATER WELL DRILLERS LOG

Washington
D 1049

9 Feb 1984 Lambert Drilling Wash
 date well completed firm name county well located

LANDOWNER:	description of formations encountered	from	to
(mailing address)			
<u>Dr. Lindsey</u> <u>Greenville, Miss.</u>	<u>Mixed</u>	<u>0</u>	<u>15'</u>
WELL LOCATION: sec. <u>2</u> T <u>15</u> N R <u>8</u> E <u>2</u> miles <u>N</u> of <u>Greenville</u> (distance) (direction) (nearest town)	<u>Sand & gravel</u>	<u>15</u>	<u>30</u>
WELL PURPOSE: <u>home</u> (home, irrigation, municipal, industrial)	<u>Sand</u>	<u>30</u>	<u>70</u>
WELL COMPLETION DATA:	<u>Sand & gravel</u>	<u>70</u>	<u>110</u>
(1) diameter (inches) <u>2</u>	<u>Clay</u>	<u>110</u>	<u>240</u>
(2) total depth (feet) <u>499</u>	<u>Clay st sand</u>	<u>240</u>	<u>380</u>
(3) static water level (feet) <u>78</u> below top of ground.	<u>Sand st clay</u>	<u>380</u>	<u>420</u>
(4) casing <u>PVC</u> , <u>475'</u> (material) (depth)	<u>Sand Pipe</u>	<u>420</u>	<u>460</u>
<u>2</u> if telescope see back. (size)	<u>Brnd.</u>	<u>460</u>	<u>495</u>
(5) screen <u>20</u> , <u>495-475'</u> (length) (depth to top)			
<u>2"</u> , <u>PVC</u> (size) (material)			
(6) pump <u>1</u> , <u>10</u> (HP) (yield gpm)			
<u>elect</u> (type power)			
(7) electric log <u>no</u> (yes or no)			
(organization running log)			
(8) how well bottom plugged <u>back plug</u>			
DRILLERS REMARKS:			


DEPT. OF NATURAL RESOURCES
 BUREAU OF LAND & WATER RESOURCES

MAR 22 1984

RECEIVED

If well telescopes please sketch and show depths.

GROUND LEVEL

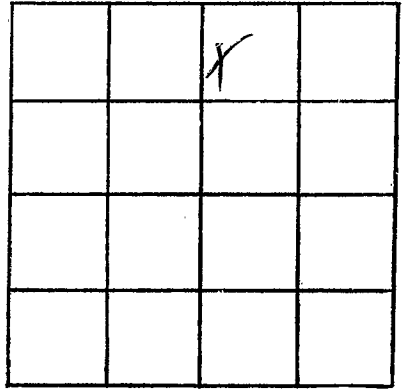

SECTION 2

Please indicate well location X.

ADDITIONAL INFORMATION

If more than one screen, show locations of each on sketch.