

MISSISSIPPI DEPARTMENT OF NATURAL RESOURCES

Bureau of Land and Water Resources

Southport Mall

P.O. Box 10631

Jackson, Mississippi 39209

WATER WELL DRILLERS LOG

Washington
 ED
 2000

9 Dec 1985 Lambert Drilling Wash
 date well completed firm name county well located

LANDOWNER:	description of formations encountered	from	to
Carlton Johnson Greenville, Miss. (mailing address)			
WELL LOCATION:	Sand	20	70
sec. 33 T. 15 N. R. 9 E 3 miles S of Greenville (distance) (direction) (nearest town)	fine gravel	70	86
WELL PURPOSE: none (home, irrigation, municipal, industrial)	blue shell	86	160
WELL COMPLETION DATA:	Clay st sand	160	200
(1) diameter (inches) 2"	Sand	200	240
(2) total depth (feet) 390	Sand. fine	240	330
(3) static water level (feet) 54 below above-top of ground.	Sand good	330	390
(4) casing PVC 370 (material) (depth)			
2 (size) if telescope see back.			
(5) screen 20 390-370 (length) (depth to top)			
2 PVC (size) (material)			
(6) pump 1 10 (HP) (yield gpm)			
elect (type power)			
(7) electric log no (yes or no)			
(organization running log)			
(8) how well bottom plugged back press.			
DRILLERS REMARKS:			


RECEIVED

MAR 11 1985

Department of Natural Resources
 Bureau of Land & Water Resources

If well telescopes please sketch and show depths.

GROUND LEVEL

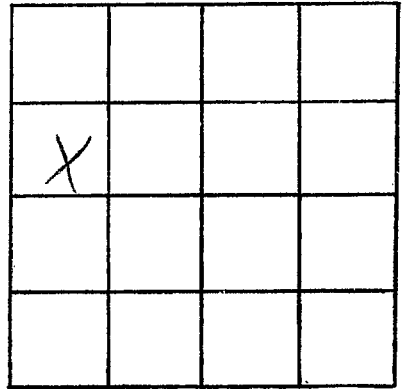

SECTION 39

Please indicate well location X.

ADDITIONAL INFORMATION

If more than one screen,
show locations of each on sketch.