

MISSISSIPPI DEPARTMENT OF NATURAL RESOURCES

Bureau of Land and Water Resources

Southport Mall

P.O. Box 10631

Jackson, Mississippi 39209

WATER WELL DRILLERS LOG

WASHINGTON
D
2001

11-19 1985 Schultz Drilling Washington
date well completed firm name county well located

LANDOWNER: FRANK McDonald
Woodmen of World Rd.
Greenville MS
(mailing address)

description of formations encountered	from	to
CLAY	0	40
SAND + pea gravel	40	80
Blue CLAY	80	140
Shale	140	400
Brown CLAY	400	450
SAND	450	480

WELL LOCATION:
sec 27 T-18 N R-8 E
2 miles E of Greenville
(distance) (direction) (nearest town)

WELL PURPOSE: HOME
(home, irrigation, municipal, industrial)

WELL COMPLETION DATA:
(1) diameter (inches) 2"
(2) total depth (feet) 480'
(3) static water level (feet) 40' below top of ground.
(4) casing PVC 470'
(material) (depth)
(size) if telescope see back.
(5) screen 10' 470'
(length) (depth to top)
2" PVC
(size) (material)
(6) pump 1 10
(HP) (yield gpm)
ELE
(type power)
(7) electric log NO
(yes or no)
X
(organization running log)
(8) how well bottom plugged b/w.


RECEIVED

DEC 3 - 1985

DRILLERS REMARKS:

If well telescopes please sketch and show depths.

GROUND LEVEL

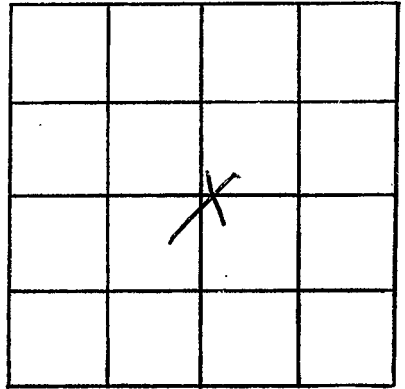

SECTION 27

Please indicate well location X.

ADDITIONAL INFORMATION

If more than one screen, show locations of each on sketch.