

MISSISSIPPI DEPARTMENT OF NATURAL RESOURCES

Bureau of Land and Water Resources

Southport Mall

P.O. Box 10631

Jackson, Mississippi 39209

WATER WELL DRILLERS LOG

WASHINGTON
D
2003

5-1586 Schultz Drilling WASHINGTON
date well completed firm name county well located

LANDOWNER: Wilber Shaw
Old Leland Rd
Greenville, MS
(mailing address)


description of formations encountered	from	to
CLAY	0	30
SAND	30	80
CLAY	80	270
SHALE	270	300
SAND	300	375

WELL LOCATION:
sec. 14 T. 18 S. R. 8 E.
4 miles W of Leland
(distance) (direction) (nearest town)

WELL PURPOSE: HOME
(home, irrigation, municipal, industrial)

WELL COMPLETION DATA:

- (1) diameter (inches) 4" X 2"
- (2) total depth (feet) 375'
- (3) static water level (feet) 28' below top of ground.
- (4) casing PVC 355'
(material) (depth)
- (size) If telescope see back.
- (5) screen 20' 355'
(length) (depth to top)
- 2" PVC
(size) (material)
- (6) pump 1 20
(HP) (yield gpm)
- ele
(type power)
- (7) electric log NO
(yes or no)
X
(organization running log)
- (8) how well bottom plugged b/w

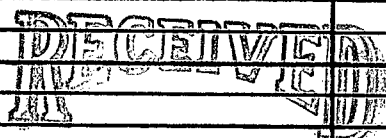

MAY 20 1986

Department of Natural Resources
Bureau of Land & Water Resources

DRILLERS REMARKS:

