

MISSISSIPPI DEPARTMENT OF NATURAL RESOURCES

Bureau of Land and Water Resources

Southport Mall

P.O. Box 10631


Jackson, Mississippi 39209

WATER WELL DRILLERS LOG

WASHINGTON
D
2004

14 Jan 1984 date well completed
Lambert Drilling firm name
Wash county well located

LANDOWNER:	description of formations encountered	from	to
Mike Reynolds Greenville, Miss. (mailing address)	Mixed	0	15
WELL LOCATION: sec. 33 T. 18 N. R. 8 E. W. 5 4 miles N/E of Greenville (distance) (direction) (nearest town)	Sand	15	45
WELL PURPOSE: none (home, irrigation, municipal, industrial)	pea gravel	45	88
WELL COMPLETION DATA:	blue shell	88	260
(1) diameter (inches) 2	Clay st sand	260	360
(2) total depth (feet) 450	Sand	360	400
(3) static water level (feet) 58 below top of ground.	Sand	400	450
(4) casing PVC, 430 (material) (depth)			
2 (size) if telescope see back.			
(5) screen 20 (length), 450-430 (depth to top)			
2 (size), PVC (material)			
(6) pump 1 (HP), 10 (yield gpm)			
elect (type power)			
(7) electric log no (yes or no)			
(organization running log)			
(8) how well bottom plugged back press			

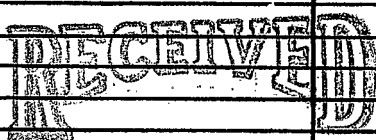


MAR 11 1986

Department of Natural Resources
Bureau of Land & Water Resources

DRILLERS REMARKS:

If well telescopes please sketch and show depths.

GROUND LEVEL

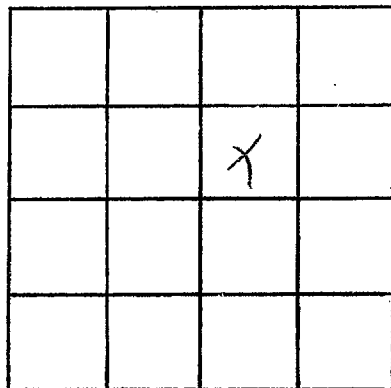

SECTION 33

Please indicate well location X.

ADDITIONAL INFORMATION

If more than one screen,
show locations of each on sketch.