

MISSISSIPPI DEPARTMENT OF NATURAL RESOURCES

Bureau of Land and Water Resources

P.O. Box 10631

Jackson, Mississippi 39209

WATER WELL DRILLERS LOG

COUNTY WELL LOCATED <i>Washington</i>	
WELL NUMBER <i>D</i>	CODED
DATE WELL COMPLETED <i>3/1/88</i>	

PERMIT NUMBER
NAME OF DRILLING FIRM <i>W & W Drilling Co</i>
<i>Greenville, Miss</i>

NAME & MAILING ADDRESS OF LANDOWNER <i>Marty Crawford</i>			
<i>Rt 3</i>			
<i>Greenville, Miss</i>			
WELL LOCATION: SEC	TOWNSHIP	RANGE	
	<i>27-T18N</i>	<i>N S</i>	<i>8W E W</i>
DISTANCE	DIRECTION	NEAREST TOWN	
<i>2</i> Miles	<i>SE</i>	of <i>Greenville</i>	
OTHER LANDMARK			
WELL PURPOSE: Home, Irrigation, Municipal, Industrial, Fish Pond, etc. <i>Home</i>			

PUMP DATA			
PUMP TYPE (Circle One): <u>Submersible</u> , Turbine, Jet, Flowing Well, Other (Describe) _____			
POWER TYPE (Circle One): <u>Electric</u> , Tractor, Diesel, Gasoline, Butane, Other (Describe) _____			
Pump Capacity (GPM) <i>20</i>	No. of Stages <i>11</i>	Setting Depth <i>510</i>	FT.
PUMP TEST			
Well yielded _____ GPM with a drawdown of _____ ft. after _____ hours of pumping			

WELL DATA		
Well Depth <i>510</i>	Casing Diameter (In.) <i>4" x 2"</i>	Casing Length (Ft.) <i>480</i>
Type of Casing <i>Plastic</i>	Hole Depth <i>525</i>	Depth to Static Water Level <i>47'</i>
TYPE OF COMPLETION: (Circle One or More): Gravel Packed, Underreamed, Telescoped, <u>Natural Development</u> , Open Hole, Other (Describe) _____		
Top of Lap Pipe or Reduction in Casing		
FEET	IF TELESCOPED OR MORE THAN ONE SCREEN: USE BACK PAGE	

LOG DATA	
TYPE OF LOG RUN (Circle One): Electric, Gamma Ray, Density, Sonic, <u>No Log Run</u> , Other (Describe) _____	
Name of Organization Running Log	

SCREEN DATA		
Diameter - Inches <i>2</i>	Length - Feet <i>30</i>	Slot Size - Inches <i>.010</i>
Screen Type <i>plastic</i>	Depth to Bottom - Feet <i>510</i>	

GEOLOGIC DATA (Office Use Only)			
Surface Elev.	Geologic Unit	Unit Thickness	Depth to Top
Subs. SWL	Date	Analysis	Aquifer Test
Driller's Remarks			
RECEIVED			


DESCRIPTION OF FORMATIONS ENCOUNTERED	FROM	TO	FORMATIONS (Continued)	FROM	TO
<i>clay</i>	<i>0</i>	<i>30</i>	MAR 22	1988	
<i>sand</i>	<i>30</i>	<i>50</i>			
<i>sand + pea gravel</i>	<i>50</i>	<i>105</i>			
<i>clay</i>	<i>105</i>	<i>295</i>			
<i>sand</i>	<i>295</i>	<i>330</i>			
<i>clay + sand</i>	<i>330</i>	<i>465</i>			
<i>sand</i>	<i>465</i>	<i>510</i>			

Department of Natural Resources
Bureau of Land & Water Resources

IF MORE SPACE IS NEEDED, USE BACK

If well telescopes please sketch and show depths.

GROUND LEVEL

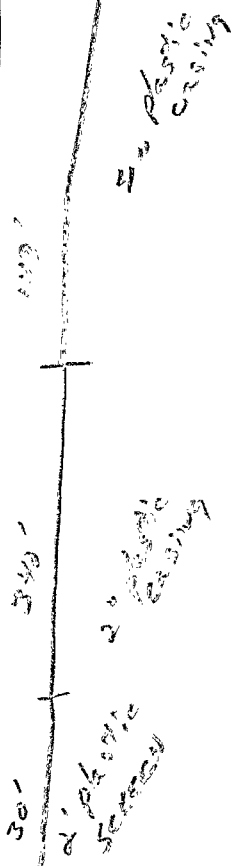

SECTION _____

Please indicate well location X.

ADDITIONAL INFORMATION

Lined area for providing additional information.

If more than one screen, show location of each on sketch.