

# MISSISSIPPI DEPARTMENT OF NATURAL RESOURCES

Bureau of Land and Water Resources

P.O. Box 10631

Jackson, Mississippi 39209

## WATER WELL DRILLERS LOG

COUNTY WELL LOCATED <i>Washington</i>	
WELL NUMBER <i>D</i>	CODED
<i>2011</i>	
DATE WELL COMPLETED <i>2-6-90</i>	

PERMIT NUMBER <i>GW 9191</i>
NAME OF DRILLING FIRM <i>Schultz Drilling</i>

NAME & MAILING ADDRESS OF LANDOWNER <i>Joel Hill</i>		
<i>RR Box 10 Hwy 82</i>		
WELL LOCATION: SEC <i>32</i> TOWNSHIP <i>18</i> RANGE <i>8</i>		
DISTANCE _____ MILES _____ of <i>Greenville</i>		
OTHER LANDMARK		
WELL PURPOSE: Home, Irrigation, Municipal, Industrial, Fish Pond, etc. <i>Home pond</i>		

PUMP DATA		
PUMP TYPE (Circle One): <input checked="" type="checkbox"/> Submersible    Turbine    Jet    Flowing Well, Other (Describe) _____		
POWER TYPE (Circle One): <input checked="" type="checkbox"/> Electric    Tractor    Diesel    Gasoline    Butane, Other (Describe) _____		
Pump Capacity (GPM) <i>600</i>	No. of Stages <i>1</i>	Setting Depth <i>60</i> FT.
PUMP TEST		
Well yielded _____ GPM with a drawdown of _____ ft. after _____ hours of pumping		

WELL DATA		
Well Depth <i>75 ft</i>	Casing Diameter (In.) <i>10 in</i>	Casing Length (Ft.) <i>55 ft</i>
Type of Casing <i>pvc</i>	Hole Depth <i>75 ft</i>	Depth to Static Water Level <i>8 ft</i>
TYPE OF COMPLETION: (Circle One or More): <input checked="" type="checkbox"/> Gravel Packed,    Underreamed,    Telescoped, Natural Development,    Open Hole,    Other (Describe) _____		
Top of Lap Pipe or Reduction in Casing  FEET    IF TELESCOPED OR MORE THAN ONE SCREEN: USE BACK PAGE		

LOG DATA	
TYPE OF LOG RUN (Circle One): <input checked="" type="checkbox"/> No Log Run, Electric, Gamma Ray, Density, Sonic, Neutron, Other (Describe) _____	
Name of Organization Running Log	

SCREEN DATA		
Diameter - Inches <i>10 in</i>	Length - Feet <i>20 ft</i>	Slot Size - Inches <i>.050</i>
Screen Type <i>pvc</i>	Depth to Bottom - Feet <i>75 ft</i>	

GEOLOGIC DATA (Office Use Only)			
Surface Elev.	Geologic Unit	Unit Thickness	Depth to Top
Subs. SWL	Date	Analysis	Aquifer Test
Driller's Remarks			


DESCRIPTION OF FORMATIONS ENCOUNTERED	FROM	TO	FORMATION
<i>Sandy loam</i>	<i>0</i>	<i>6</i>	<div style="font-size: 2em; font-weight: bold; opacity: 0.5;">RECEIVED</div> <div style="font-size: 1.5em; font-weight: bold; margin-top: 10px;">JUN 11 1990</div> <div style="font-weight: bold; margin-top: 20px;">Department of Natural Resources Bureau of Land &amp; Water Resources</div>
<i>clay streaked sand</i>	<i>6</i>	<i>30</i>	
<i>fine to med sand</i>	<i>30</i>	<i>50</i>	
<i>med. sand</i>	<i>50</i>	<i>60</i>	
<i>course sand</i>	<i>60</i>	<i>70</i>	
<i>course sand and p-gravel</i>	<i>70</i>	<i>75</i>	

IF MORE SPACE IS NEEDED, USE BACK

If well telescopes please sketch and show depths.

GROUND LEVEL ↗

55 ft  
10 ft

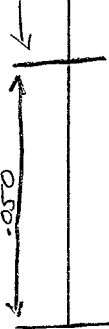

		X	

SECTION 32

Please indicate well location X.

ADDITIONAL INFORMATION

If more than one screen, show location of each on sketch.