

MISSISSIPPI DEPARTMENT OF ENVIRONMENTAL QUALITY
Bureau of Land and Water Resources

P. O. Box 10631
Jackson, MS 39289-0631
WATER WELL DRILLERS LOG

COUNTY WELL LOCATED Washington	
WELL NUMBER 1 D	CODED 2
3-76-82	
DATE WELL COMPLETED 3-18-92	

PERMIT NUMBER
NAME OF DRILLING FIRM CBS Drilling

NAME & MAILING ADDRESS OF LANDOWNER Tom Gresham		
P.O. Box 690		
Indianola, Mo. 38751		
WELL LOCATION: SEC	TOWNSHIP	RANGE
32	T18 N	R8 W
DISTANCE	DIRECTION	NEAREST TOWN
2 1/2 Miles	W	Gheville
OTHER LANDMARK		
WELL PURPOSE: <u>Home</u> Irrigation, Municipal, Industrial, Fish Pond, etc.		

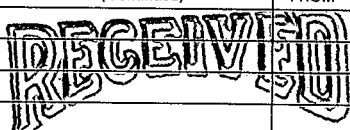
PUMP DATA		
PUMP TYPE (Circle One): <u>Submersible</u> , Turbine, Jet, Flowing Well, Other (Describe) _____		
POWER TYPE (Circle One): <u>Electric</u> , Tractor, Diesel, Gasoline, Butane, Other (Describe) _____ H/P 1		
Pump Capacity (GPM) 18	No. of Stages 8	Setting Depth 105 FT.
PUMP TEST		
Well yielded 18 GPM with a drawdown of 62 ft. after 8 hours of pumping		

WELL DATA		
Well Depth 479	Casing Diameter (In.) 4"	Casing Length (Ft.) 459
Type of Casing PVC	Hole Depth 584	Depth to Static Water Level 32
TYPE OF COMPLETION: (Circle One or More): Gravel Packed, Underreamed, Telescoped, <u>Natural Development</u> , Open Hole, Other (Describe) _____		
Top of Lap Pipe or Reduction in Casing		
FEET	IF TELESCOPED OR MORE THAN ONE SCREEN: USE BACK PAGE	

LOG DATA	
TYPE OF LOG RUN (Circle One): No Log Run, Electric, Gamma Ray, Density, Sonic, Neutron, Other (Describe) _____	
Name of Organization Running Log	

SCREEN DATA		
Diameter - Inches 4"	Length - Feet 20	Slot Size - Inches .010
Screen Type PVC	Depth to Bottom - Feet 479	

GEOLOGIC DATA (Office Use Only)			
Surface Elev.	Geologic Unit	Unit Thickness	Depth to Top
Subs. SWL	Date	Analysis	Aquifer Test
Driller's Remarks			

DESCRIPTION OF FORMATIONS ENCOUNTERED	FROM	TO	FORMATIONS (Continued)	FROM	TO
TOP SOIL & Clay	0	11	 MAY 27 1992 Dept. of Environmental Quality Bureau of Land & Water Resources		
SAND	11	61			
SAND & GRAVEL	61	102			
Clay	102	212			
Clay & ST. SAND	212	231			
ROCK	231	232			
SAND & shale	232	308			
@ Shale	308	341			
SAND & Rock	341	402			
SAND	402	480			
IF MORE SPACE IS NEEDED, USE BACK					

