

MISSISSIPPI DEPARTMENT OF ENVIRONMENTAL QUALITY
Bureau of Land and Water Resources

COUNTY WELL LOCATED <u>Washington</u>	
WELL NUMBER <u>D</u>	CODED
DATE WELL COMPLETED <u>2017</u> <u>4-10-92</u>	

PERMIT NUMBER GW - 13600
NAME OF DRILLING FIRM <u>Schudco Ltrd</u>

145801464 P. O. Box 10631
Jackson, MS 39289-0631
WATER WELL DRILLERS LOG

NAME & MAILING ADDRESS OF LANDOWNER <u>G T and T Farms</u>			
<u>24 Abide Dr</u>			
<u>Greenville MS</u>			
WELL LOCATION: SEC	TOWNSHIP	RANGE	
<u>NW SW 37</u>	<u>18</u>	<u>N 8 E</u>	
DISTANCE	DIRECTION	NEAREST TOWN	
<u>100 yds</u>	<u>West</u>	<u>Greenville</u>	
OTHER LANDMARK			
WELL PURPOSE: Home, <u>Irrigation</u> , Municipal, Industrial, Fish Pond, etc.			

PUMP DATA		
PUMP TYPE (Circle One): Submersible, <u>Turbine</u> Jet Flowing Well, Other (Describe) _____		
POWER TYPE (Circle One): <u>Electric</u> Tractor, Diesel, Gasoline, Butane, Other (Describe) _____ H/P <u>60</u>		
Pump Capacity (GPM)	No. of Stages	Setting Depth
<u>3000</u>	<u>1</u>	<u>60</u> FT.
PUMP TEST		
Well yielded _____ GPM with a drawdown of _____ ft. after _____ hours of pumping		

WELL DATA		
Well Depth <u>89</u>	Casing Diameter (In.) <u>16</u>	Casing Length (Ft.) <u>49</u>
Type of Casing <u>pvc</u>	Hole Depth <u>89</u>	Depth to Static Water Level <u>27</u>
TYPE OF COMPLETION: (Circle One or More): <u>Gravel Packed</u> , Underreamed, Telescoped, Natural Development, Open Hole, Other (Describe) <u>Hole plug</u>		
Top of Lap Pipe or Reduction in Casing		
FEET	IF TELESCOPED OR MORE THAN ONE SCREEN: USE BACK PAGE	

LOG DATA	
TYPE OF LOG RUN (Circle One): <u>No Log Run</u> Electric, Gamma Ray, Density, Sonic, Neutron, Other (Describe) _____	
Name of Organization Running Log	

SCREEN DATA		
Diameter - Inches <u>16</u>	Length - Feet <u>40</u>	Slot Size - Inches <u>.050</u>
Screen Type <u>pvc</u>	Depth to Bottom - Feet <u>89</u>	

GEOLOGIC DATA (Office Use Only)			
Surface Elev.	Geologic Unit	Unit Thickness	Depth to Top
Subs. SWL	Date	Analysis	Aquifer Test

Driller's Remarks


DESCRIPTION OF FORMATIONS ENCOUNTERED	FROM	TO	FORMATIONS (Continued)	
			FROM	TO
<u>Top soil</u>	<u>0</u>	<u>5</u>	RECEIVED	AUG 11 1992
<u>clay</u>	<u>5</u>	<u>25</u>		
<u>sand</u>	<u>25</u>	<u>50</u>		
<u>sand + p-gravel</u>	<u>50</u>	<u>89</u>		
<u>clay</u>	<u>89</u>			

IF MORE SPACE IS NEEDED, USE BACK

Dept. of Environmental Quality
Bureau of Land & Water Resources

If well telescopes please
sketch and show depths.

GROUND LEVEL

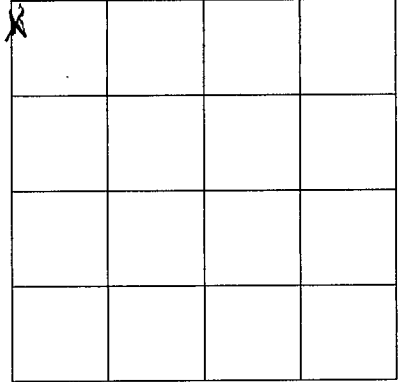

SECTION 36

Please indicate well location X.

ADDITIONAL INFORMATION

If more than one screen,
show location of each on sketch.