

Washington
 MS
 D. D. D.

MISSISSIPPI DEPARTMENT OF NATURAL RESOURCES
 Bureau of Land and Water Resources
 Southport Mall
 P.O. Box 10631
 Jackson, Mississippi 39209
WATER WELL DRILLERS LOG

July 31 1985 date well completed
 Larry's Well's pump firm name
 Washington county well located

LANDOWNER: Robert Jenkins
 description of formations encountered
 from to
 Greenville ms (mailing address)
 Sand 420 520

WELL LOCATION:
 sec. 19 T. 18 S. R. 7 W.
 2 miles E of Greenville
 (distance) (direction) (nearest town)

WELL PURPOSE:
 (home, irrigation, municipal, industrial)

- WELL COMPLETION DATA:
- (1) diameter (inches) 4" x 2"
 - (2) total depth (feet) 520
 - (3) static water level (feet) 20 below top of ground.
 - (4) casing PVC, 490 (material) (depth)
 4x2 (size) if telescope see back.
 - (5) screen 2" 480 to 520 (length) (depth to top)
 2" PVC (size) (material)
 - (6) pump 1 70 (HP) (yield gpm)
 220 (type power)
 - (7) electric log NO (yes or no)
 (organization running log)
 - (8) how well bottom plugged SHARK

RECEIVED

MAY 11 1997

Department of Natural Resources
 Bureau of Land & Water Resources

DRILLERS REMARKS:


If well telescopes please sketch and show depths.

GROUND LEVEL

120' 4" pvc

360' 2" pvc

40' pvc screen

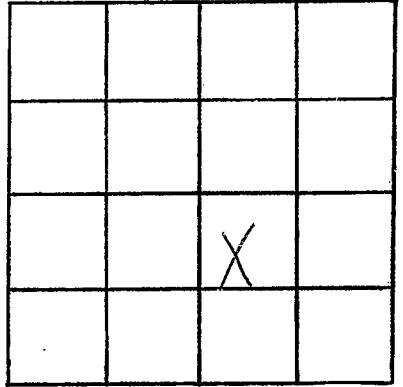

SECTION 19

Please indicate well location X.

ADDITIONAL INFORMATION

If more than one screen, show locations of each on sketch.