

9/17/65
Jm
C387

~~E11~~
3-20-57

WATER WELL DRILLERS LOG

March 20, 1957, Driller: Layne-Central Company County Washington

(Name)

- (1) Owner of Land: C. K. Fuller
(Name)
Leland, Mississippi
(Address)
- (2) Location: 1/4, 1/4, Sec. 7 T18R7,
6 miles west of Leland
(distance) (direction) (Nearest Town)
- (3) Topography: flat
(Hilly) (Flat) (Level)
- (4) Purpose of Well: irrigation
(Domestic Irrigation
Municipal, Industrial, Other)

Description & Color of Materials Sand, Clay, Red Clay, Shell, etc.	Thick- ness Feet	Depth Feet
Blue clay	28	28
Fine brown sand	8	36
Fine blue sand	11	47
Coarse sand	5	52
Coarse sand	10	62
Coarse sand & pea rock	10	72
Sand & pea rock	10	82
Sand & gravel	9	91

Information upon completion of well:


- (1) Diameter 16x12 inches.
- (2) Total Depth 91 feet.
- (3) Water Level 17' 4" feet below top of ground.
- (4) Cased to 49' Size 16"
2' of 16" x 12" swage
- (5) Screen: Size 12", Length 40'
- (6) Were any formations sealed against pollution?
no yes, no no.

If YES depth of formation _____

Why _____

Drillers Remarks: _____

Engine Drive. _____

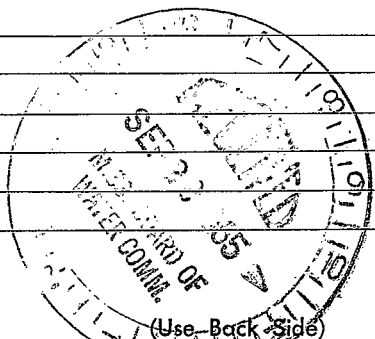

Well No. _____

