

E37

12-17-63

WATER WELL DRILLERS LOG

c16 94
12/31/63
[Signature]

Dec. 17, 1963, Driller: Layne-Central Company County Washington

(Name)

(1) Owner of Land: Walker Frams, Inc.
(Name)

Stoneville, Mississippi
(Address)

(2) Location: 1/4, 1/4, Sec. 10 T. 87N, R. 7W
_____ miles _____ of Stoneville,
(distance) (direction) (Nearest Town)

(3) Topography: flat
(Hilly) (Flat) (Level)

(4) Purpose of Well: domestic - industrial
(Domestic Irrigation Municipal, Industrial, Other)


Information upon completion of well:

- (1) Diameter 6 x 8 inches.
- (2) Total Depth 480' - 10" feet.
- (3) Water Level 33' - 10" feet below top of ground.
- (4) Cased to 101' - 11", Size 8"
30' - 1 1/2" 6" Blank
- (5) Screen: Size 6", Length 41' - 6"
7' - 4" B.P.V.
- (6) Were any formations sealed against pollution?
yes yes, _____ no.

If YES depth of formation Cemented, packer,
lead seal and mechanical seal
Why _____

Drillers Remarks: _____

Description & Color of Materials Sand, Clay, Red Clay, Shell, etc.	Thickness Feet	Depth Feet
Clay	20	20
Coarse sand	64	84
Coarse sand, fine pea gravel	11	95
Clay	11	106
Rock	3	109
Clay	2	111
Rock	2	113
Clay	6	119
Sandy shale	65	184
Gummy clay	82	266
Sandy shale, lignite	26	292
Sandy clay	44	336
Gummy white clay	23	359
Rock	5	364
Sandy shale	45	409
Rock, white sand	67	476
Blue clay	22	498

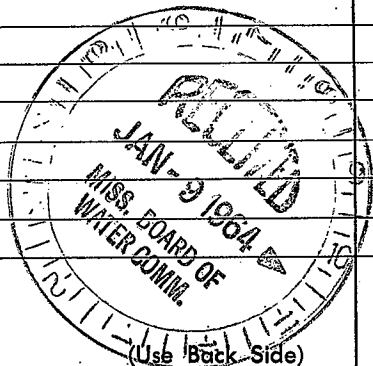

Well No.

