

WASH.

MISSISSIPPI BOARD OF WATER COMMISSIONERS

E 38

6-27-62

WATER WELL DRILLERS LOG

7/6/62  
1330

Date: June 27, 1962, Driller: Layne-Central Company County Washington.

(Name)

(1) Owner of Land: Walker Farms Dairy

(Name)

Stoneville, Mississippi

(Address)

(2) Location: 1/4, 1/4, Sec. 4 T18N R7W

       miles       , of         
(distance) (direction) (Nearest Town)

(3) Topography: flat  
(Hilly) (Flat) (Level)

(4) Purpose of Well: industrial  
(Domestic Irrigation  
Municipal, Industrial, Other)

Description & Color of Materials Sand, Clay, Red Clay, Shell, etc.	Thick- ness Feet	Depth Feet
Clay	12	12
Fine sand	28	40
Coarse sand	66	106
Rock	2	108
Pink clay	12	120
Sandy shale	210	330
Pink hard clay	67	397
Rocky shale	2	399
Sandy shale	55	454
Rock sand	42	496
Rock, sand, shale streaks	26	522


Information upon completion of well:

- (1) Diameter 6x8 inches.
- (2) Total Depth 510' - 4" feet.
- (3) Water Level 32 feet below top of ground.
- (4) Cased to 449' 7" Size 8"  
Inner casing 20' 10" 6"
- (5) Screen: Size 6", Length 41' 4"  
B.P. Valve 10' 4"
- (6) Were any formations sealed against pollution?  
yes yes,        no.

If YES depth of formation sealed all the way.

Why to eliminate all other formations.

Drillers Remarks:

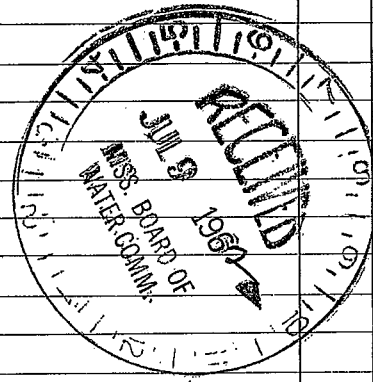

(Use Back Side)

Well No.

