

Washington
 E39
 9-67
 Elec Log

MISSISSIPPI
 BOARD OF WATER COMMISSIONERS
 416 North State Street
 Jackson, Mississippi 39201

WATER WELL DRILLERS LOG

9-12
 date well completed

1967 Layne Central Co.
 firm name

Washington
 county well located

LANDOWNER: City of
Leland, Miss.

Leland, Miss.
 (mailing address)

WELL LOCATION: West 2nd Street
 sec. 15 T. 18 N. R. 7 E
Cor Pippin St 1/2 mi 2nd St.
 (distance) miles (direction) of (nearest town)

WELL PURPOSE: Municipal
 (home, irrigation, municipal, industrial)

WELL COMPLETION DATA:

- (1) diameter (inches) 18"
- (2) total depth (feet) 652'
- (3) static water level (feet) 44' below top of ground.
- (4) casing Steel, 590'
 (material) (depth)
18" If telescope see back.
 (size)
- (5) screen 50', 596'
 (length) (depth to top)
10", stainless steel
 (size) (material)
- (6) pump 75
 (HP) (yield gpm)
Electric
 (type power)
- (7) electric log Yes E-log #57
 (yes or no)
- Miss. GEO. SURVEY
 (organization running log)
- (8) how well bottom plugged Valve


description of formations encountered	from	to
Yellow Clay	0	12
Sand (Brown)	12	31
Blue Clay	31	39
Sand + Gravel	39	109
Clay	109	159
Sandy Clay	159	175
Clay, Silt + Hard Stks	175	290
Rock	290	291
Hard Clay	291	347
Clay, Sandy Stks	347	471
Rock	471	472
Shale	472	490
Sandy Shale	490	503
Fine Sand, Stks, Clay	503	570
Clay, Stks of Sand	570	590
Sand	590	651
Fine Sand + lignite	651	706



DRILLERS REMARKS:
Pump not installed as of
this date - No test has been
run on this well

If well telescopes please sketch and show depths.

GROUND LEVEL

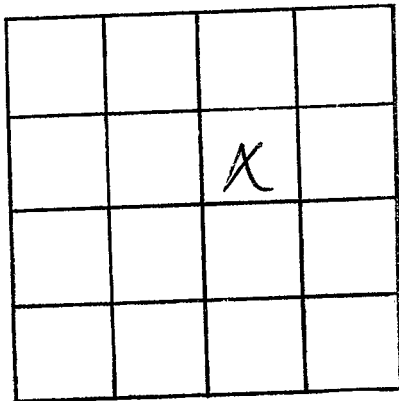

SECTION 15

Please indicate well location X.

ADDITIONAL INFORMATION

Lined area for additional information.

If more than one screen, show locations of each on sketch.