

Washington
E 41
10-67

MISSISSIPPI
BOARD OF WATER COMMISSIONERS
416 North State Street
Jackson, Mississippi 39201

WATER WELL DRILLERS LOG

10/17 1967 Bailey Drlg. Co. Washington
date well completed firm name county well located

LANDOWNER: Elizabeth Waterless
Elizabeth
Miss.
(mailing address)


description of formations encountered	from	to
	Clay	0
Sand	18	85
Gravel	85	106
Mud	106	400
Sand	400	522

WELL LOCATION:
sec. 12 T 18 N R 7 W
at Elizabeth
(distance) (direction) (nearest town)

WELL PURPOSE: Community
(home, irrigation, municipal, industrial)

WELL COMPLETION DATA:

- (1) diameter (inches) 8 x 4
- (2) total depth (feet) 522
- (3) static water level (feet) 31 below above top of ground.
- (4) casing steel, 482, (material), (depth), 8 x 4 (size) if telescope see back.
- (5) screen 40' 482 (length), (depth to top), 4" Stainless Steel (size), (material)
- (6) pump 10 100 (HP), (yield gpm), Elec (type power)
- (7) electric log No (yes or no)

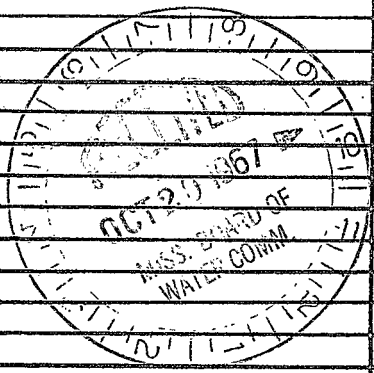

(organization running log)
(8) how well bottom plugged Back pressure valve

DRILLERS REMARKS:

