

Washington  
E 46  
11-67

MISSISSIPPI  
BOARD OF WATER COMMISSIONERS  
416 North State Street  
Jackson, Mississippi 39201

WATER WELL DRILLERS LOG

11-17-1967 date well completed  
Layne Central Co. firm name  
Washington county well located

LANDOWNER: City of  
Leland, Miss.  
Leland, Miss.  
(mailing address)


WELL LOCATION: next to new  
water tank  
sec. 18 T 18 N R 7 E  
SW 1/4 NE 1/4  
4 8 miles of (direction) (nearest town)

WELL PURPOSE: Municipal  
(home, irrigation, municipal, industrial)

WELL COMPLETION DATA:

- (1) diameter (inches) 18"
- (2) total depth (feet) 652'
- (3) static water level (feet) 40' below top of ground.
- (4) casing Steel, 577' (material) (depth)  
18" (size) if telescope see back.
- (5) screen 60', 585 (length) (depth to top)  
10" Stainless Steel (size) (material)
- (6) pump 75 (HP) (yield gpm)  
Electric (type power)
- (7) electric log no (yes or no)  
(organization running log)
- (8) how well bottom plugged Valve


description of formations encountered	from to	
Fill	0	2
Crumbly Clay	2	42
Sand and Gravel	42	114
Spittle Clay	114	183
Rock	183	184
Hard Clay	184	300
Clay Sandy Streaks	300	321
Thin Sand & Streaks of Clay	321	374
Rock	374	375
Clay	375	426
Rock	426	427
Clay Sandy Streaks	427	477
Thin Sand & Lignite	477	510
Rock	510	511
Sand and Lignite	511	625

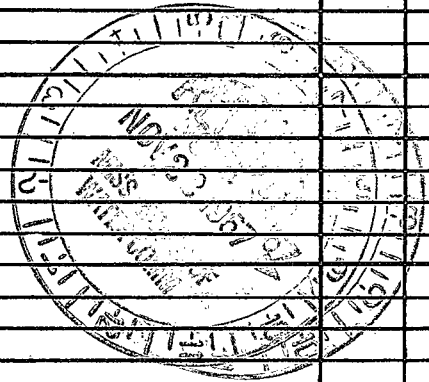

DRILLERS REMARKS:  
Test not run as of this date.

If well telescopes please sketch and show depths.

GROUND LEVEL

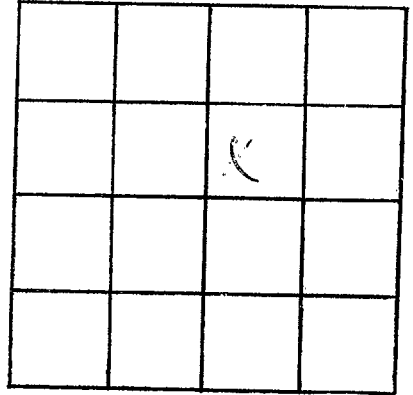

SECTION 15

Please indicate well location X.

ADDITIONAL INFORMATION

If more than one screen,  
show locations of each on sketch.