

Permit # GW05059

E 49
7-2-64

WATER WELL DRILLERS LOG

10/17/64
21830

Date: July 2, 19 64, Driller: Layne-Central Company County Washington

(Name)

This is now Livingston Farms (on permit)

(1) Owner of Land: Gilnockie Planting Co.

(Name)

Stoneville, Mississippi

(Address)

T18N

(2) Location: 1/4, 1/4, Sec. 1 T. R7W

1 miles north, of Elizabeth

(distance)

(direction)

(Nearest Town)

(3) Topography: flat

(Hilly)

(Flat)

(Level)

(4) Purpose of Well: irrigation

(Domestic Irrigation
Municipal, Industrial, Other)

Description & Color of Materials
Sand, Clay, Red Clay, Shell, etc.

Thick-
ness
Feet

Depth
Feet

Clay

18

18

Fine sand

37

55

Coarse sand

13

68

Coarse sand & pea gravel

44

112

Information upon completion of well:

(1) Diameter 12 inches.

(2) Total Depth 112 feet.

(3) Water Level 21' - 1" feet below top of ground.

(4) Cased to 72', Size 12"

(5) Screen: Size 12", Length 40'


(6) Were any formations sealed against pollution?

no yes, no no.

If YES depth of formation _____

Why _____

Drillers Remarks: _____

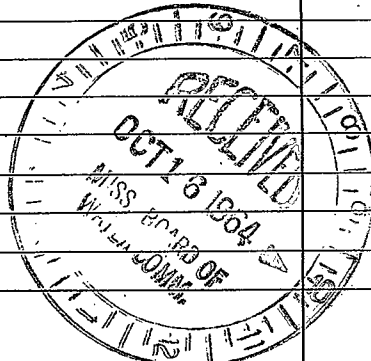

(Use Back Side)

Well No.

