

WASH. MISSISSIPPI BOARD OF WATER COMMISSIONERS

E 50

Permit # GW05060

7-24-57

WATER WELL DRILLERS LOG

CODED

10/12/65
449

Date: July 24, 1957, Driller: Layne-Central Company County Washington

(Name)

Now Elizabeth Gin, Inc. on permit
(1) Owner of Land: Gilnockie Planting Co.
(Name)

Stoneville, Mississippi

(Address)

(2) Location: SW 1/4, NW 1/4, Sec 1 T16R7

miles of Stoneville,
(distance) (direction) (Nearest Town)

(3) Topography: flat
(Hilly) (Flat) (Level)

(4) Purpose of Well: domestic
(Domestic Irrigation
Municipal, Industrial, Other)

Description & Color of Materials Sand, Clay, Red Clay, Shell, etc.	Thick- ness Feet	Depth Feet
Clay	18	18
Fine sand	22	40
Coarse sand	28	68
Coarse sand & pea gravel	39	107
Clay, streaks of sand	43	150
Clay	42	192
Rock	1	193
Shale	17	210
Sandy shale	70	280
Clay	25	305
Clay, streaks of sand	105	410
Shale	46	456
Sand, streaks of clay	14	470
Sand	40	510
Clay	4	514

Information upon completion of well:

(1) Diameter 6x4 inches.

(2) Total Depth 515 feet.

(3) Water Level 22' 7" feet below top of ground.

(4) Cased to 361' 4" Size 4"
109' 6" Size 6"
1' of 6" x 4" swage

(5) Screen: Size 35' Length 6"
7' lap

(6) Were any formations sealed against pollution?

yes yes, no.

If YES depth of formation Lead seal at top of screen; 5' slug bottom.

Why


Drillers Remarks:

100 GPM.

Electric power.

CODED

**Insufficient
Partial info to
locate.**

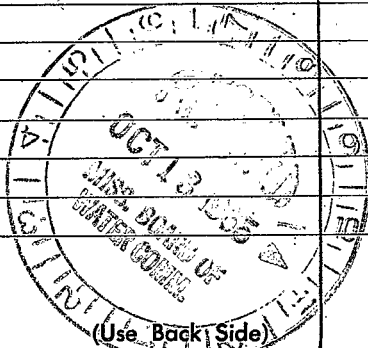

Well No.

