

WASH.

E 300

E 51
8-17-60

WATER WELL DRILLERS LOG

Date: 8/17, 1960, Driller: Layne-Central Co. County Washington

(Name)

(1) Owner of Land: Walker Farms, Inc.

(Name)

Stoneville, Mississippi

(Address)

(2) Location: 1/4, NE 1/4, Sec. 9 T18R7W

miles Northwest of Stoneville

(distance) (direction) (Nearest Town)

West of Walker House on Deer creek.

(3) Topography: (Hilly) (Flat) (Level)

(4) Purpose of Well: irrigation

(Domestic, Irrigation, Municipal, Industrial, Other)

Information upon completion of well:

(1) Diameter 12" inches.

(2) Total Depth 111 feet.

(3) Water Level 19'-9" feet below top of ground.

(4) Cased to 91', Size 12"

(5) Screen: Size 12", Length 40'

(6) Were any formations sealed against pollution?

yes, no.

If YES depth of formation _____

Why _____


Drillers Remarks: _____

Description & Color of Materials
Sand, Clay, Red Clay, Shell, etc.

Thick-
ness
Feet

Depth
Feet

Clay	12	12
Fine sand	13	25
Clay	19	44
Fine sand	23	67
Coarse sand & Pea gravel	45	112

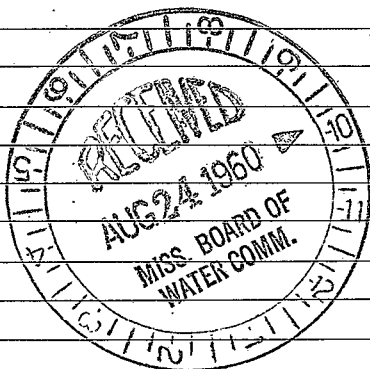

(Use Back Side)

Well No.

