

WASH.

E52

12-27-60

MISSISSIPPI BOARD OF WATER COMMISSIONERS

WATER WELL DRILLERS LOG

CODED

E 301

Date: 12/27, 1960, Driller: Bailey Drilling Co. County: Washington (Name)

- (1) Owner of Land: Charlie Frater
(Name)
Leland, Miss.
(Address)
- (2) Location: SW 1/4, SE 1/4, Sec. 34 T 18 R 7
Hwy 61 S,
2 1/2 miles South of Leland,
(distance) (direction) (Nearest Town)
- (3) Topography: Flat
(Hilly) (Flat) (Level)
- (4) Purpose of Well: Domestic
(Domestic Irrigation
Municipal, Industrial, Other)

Description & Color of Materials Sand, Clay, Red Clay, Shell, etc.	Thick- ness Feet	Depth Feet
<u>Clay</u>	<u>30</u>	<u>30</u>
<u>Sand</u>	<u>40</u>	<u>70</u>
<u>Gravel + Sand</u>	<u>90</u>	<u>160</u>
<u>Mud</u>	<u>140</u>	<u>300</u>
<u>Mud + Sand</u>	<u>48</u>	<u>348</u>
<u>Sand</u>	<u>103</u>	<u>451</u>

Information upon completion of well:


- (1) Diameter 4x2 inches.
- (2) Total Depth 440 feet.
- (3) Water Level 28 feet below top of ground.
- (4) Cased to bottom, Size 4x2.
- (5) Screen: Size 2, Length 20ft.
- (6) Were any formations sealed against pollution?
_____ yes, X no.

If YES depth of formation _____

Why _____

Drillers Remarks: _____

CODED

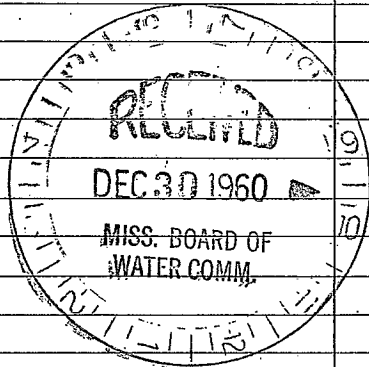

(Use Back Side)

Well No.

