

WASH. MISSISSIPPI BOARD OF WATER COMMISSIONERS

~~133~~ E53

2-12-57

WATER WELL DRILLERS LOG

C-360

Date: Feb. 12, 1957, Driller: Layne-Central Company County Washington

(Name)

(1) Owner of Land: E. E. Cooper
(Name)
Leland, Mississippi
(Address)

(2) Location: 1/4, 1/4, Sec. 35 T18N R7W
6 miles south of Leland
(distance) (direction) (Nearest Town)

(3) Topography: flat
(Hilly) (Flat) (Level)

(4) Purpose of Well: irrigation
(Domestic Irrigation
Municipal, Industrial, Other)

Description & Color of Materials Sand, Clay, Red Clay, Shell, etc.	Thick- ness Feet	Depth Feet
Clay	18	18
Clay & fine blue sand	8	26
Fine sand	14	40
Med. coarse sand	12	52
Coarse sand	10	62
Sand & pea rock	10	72
Sand & pea rock	20	92
Sand & gravel	20	112
Coarse sand & gravel	5	117

Information upon completion of well:

(1) Diameter 12 inches.

(2) Total Depth 117 feet.

(3) Water Level 20' -4" feet below top of ground.

(4) Cased to 67', Size 12"

(5) Screen: Size 12", Length 50'

(6) Were any formations sealed against pollution?
no yes, no no.


If YES depth of formation _____

Why _____

Drillers Remarks: _____

1865 GPM

engine drive

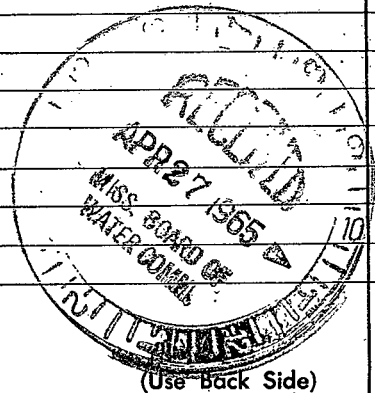

(Use Back Side)

Well No.

