

E 54

11-19-63

WATER WELL DRILLERS LOG

Date: 11/19, 1963, Driller: Radley Drlg Co County: Washington
 (Name)

(1) Owner of Land: E E Cooper
 (Name)
Leland, Miss.
 (Address)

(2) Location: 1/4, 1/4, Sec. 34 T R
Hwy 61 S
3 miles SE of Leland
 (distance) (direction) (Nearest Town)

(3) Topography: Flat
 (Hilly) (Flat) (Level)


(4) Purpose of Well: Farm
 (Domestic Irrigation
 Municipal, Industrial, Other)

Description & Color of Materials Sand, Clay, Red Clay Shell, etc.	Thick-ness Feet	Depth Feet
<u>Clay</u>		<u>30</u>
<u>Sand</u>		<u>60</u>
<u>Gravel</u>		<u>90</u>
<u>Mud</u>		<u>389</u>
<u>Sand</u>		<u>440</u>

Information upon completion of well:

- (1) Diameter 4 X 2 inches.
- (2) Total Depth 440 feet.
- (3) Water Level 25 feet below top of ground.
- (4) Cased to all way Size 4 X 2.
- (5) Screen: Size 2 Length 20 ft.
- (6) Were any formations sealed against pollution?
 ___ yes, X no.

If YES depth of formation _____
 Why _____
 Drillers Remarks: _____

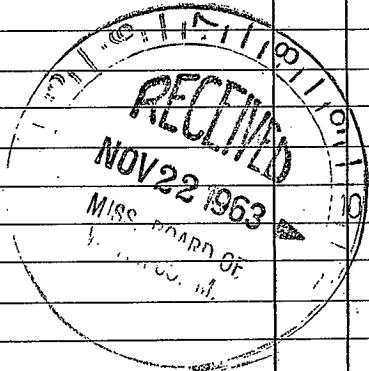

Well No.

(Use Back Side)

