

E55

5-27-64

WATER WELL DRILLERS LOG

Date: MAY 27, 1964, Driller: DELTA DRILLING Co. County WASHINGTON

(Name)

(1) Owner of Land: T.L. HORTON

(Name)

LELAND, MISS.

(Address)

(2) Location: NW 1/4, NW 1/4, Sec. 29 T R

\_\_\_\_\_ miles \_\_\_\_\_

(distance)

in Leland

(Nearest Town)

(3) Topography: \_\_\_\_\_

(Hilly)

(Flat)

(Level)

(4) Purpose of Well: DOMESTIC

(Domestic Irrigation  
Municipal, Industrial, Other)

Description & Color of Materials Sand, Clay, Red Clay, Shell, etc.	Thick- ness Feet	Depth Feet
GUMBO	66	66
GRAVEL	72	138
GUMBO	61	199
SAND	16	215
GUMBO	14	229
SAND	47	276
GUMBO	31	307
SHALE	60	367
GUMBO	10	377
FINE SAND	22	399
SAND	60	459

Information upon completion of well:

(1) Diameter 4 inches.

(2) Total Depth 459 feet.

(3) Water Level 18 feet below top of ground.

(4) Cased to 449, Size 63'-4" / 108'-3" / 290'-2"

(5) Screen: Size 2", Length 10' SS

(6) Were any formations sealed against pollution?

\_\_\_\_\_ yes, \_\_\_\_\_ no.


If YES depth of formation \_\_\_\_\_

Why \_\_\_\_\_

Drillers Remarks: 3/4 H.P. RED JACKET

DEEP WELL SUBMERSIBLE PUMP

SET 43' IN WELL

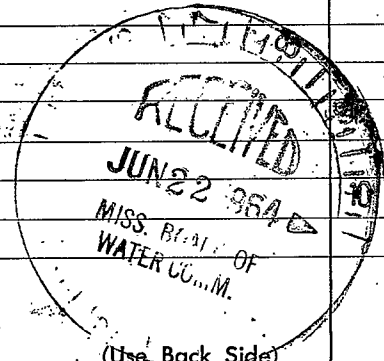

(Use Back Side)

Well No.

1000