

E 56

12-1-64

WATER WELL DRILLERS LOG

Date: 12/1, 1964, Driller: Bailey Drilling Co. County: Washington
 (Name)

(1) Owner of Land: Victor L. Ayres
 (Name)
Leland, Miss.
 (Address)

(2) Location: SW 1/4, SE 1/4, Sec. 16 T. R.
 Co. Bldg on Hwy 82 W
1 miles W Leland
 (distance) (direction) (Nearest Town)

(3) Topography: Flat
 (Hilly) (Flat) (Level)

(4) Purpose of Well: Industrial
 (Domestic Irrigation
 Municipal, Industrial, Other)

Description & Color of Materials Sand, Clay, Red Clay, Shell, etc.	Thick- ness Feet	Depth Feet
<u>Clay</u>		<u>20</u>
<u>Sand</u>		<u>80</u>
<u>Gravel + Sand</u>		<u>160</u>
<u>Mud</u>		<u>460</u>
<u>Sand</u>		<u>513</u>


Information upon completion of well:

- (1) Diameter 4 inches.
- (2) Total Depth 513 feet.
- (3) Water Level 40 feet below top of ground.
- (4) Cased to all way, Size 4
- (5) Screen: Size 4", Length 30 ft
- (6) Were any formations sealed against pollution?
 _____ yes, X no.

If YES depth of formation _____

Why _____

Drillers Remarks: _____

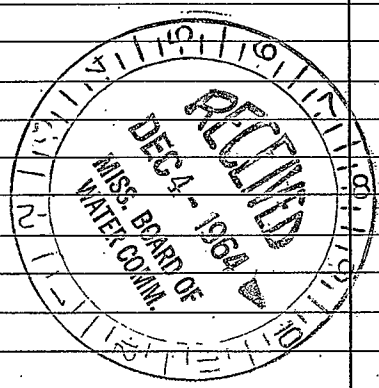

(Use Back Side)

Well No.

