

Washington
E 60
 5-66

MISSISSIPPI BOARD OF WATER COMMISSIONERS

WATER WELL DRILLERS LOG

CODED *6/8/66 well # 3*
C 2196

Date: May 17, , 19 66 , Driller: Layne-Central Company County Washington
 (Name)

(1) Owner of Land:	Description & Color of Materials	Thick-ness Feet	Depth Feet
University <u>Mississippi State</u> (Name)	Sand, Clay, Red Clay, Shell, etc.		
<u>Stoneville, Mississippi</u> (Address)	<u>Top clay</u>	23	23
(2) Location: <u>SE ¼, NW ¼, Sec. 10 T8R7</u>	<u>Fine brown sand</u>	9	32
<u>_____</u> miles, of <u>Stoneville</u> (distance) (direction) (Nearest Town)	<u>Coarse brown sand</u>	10	42
(3) Topography: <u>flat</u> (Hilly) (Flat) (Level)	<u>Coarse sand, pea gravel</u>	10	52
(4) Purpose of Well: <u>irrigation</u> (Domestic Irrigation Municipal, Industrial, Other)	<u>Coarse sand, pea gravel</u>	20	72
	<u>Coarse sand</u>	10	82
	<u>Coarse sand & gravel</u>	10	92
	<u>Coarse sand & gravel</u> (bottomed out in clay)	8	100


Information upon completion of well:

- (1) Diameter 8 inches.
- (2) Total Depth 100 feet.
- (3) Water Level 20' 7" feet below top of ground.
- (4) Cased to 72', Size 8"
- (5) Screen: Size 8", Length 30'
- (6) Were any formations sealed against pollution?
_____ yes, no no.

If YES depth of formation _____
 Why _____

Drillers Remarks: _____

CODED

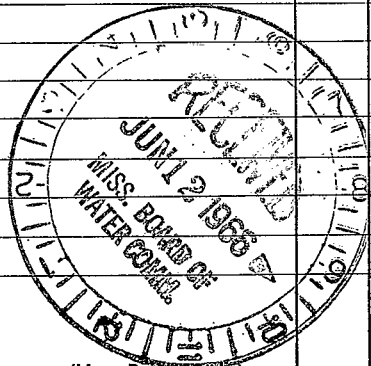

Well No.

(Use Back Side)

