

Washington

E61

3-67

MISSISSIPPI
 BOARD OF WATER COMMISSIONERS
 416 North State Street
 Jackson, Mississippi 39201

WATER WELL DRILLERS LOG

3/24 19 67 date well completed
 Bailey Drlg. Co. firm name
 Washington county well located

LANDOWNER: W. S. Forestry

description of formations encountered

from to

Stonerille
Miss.

(mailing address)

Clay	0	10
Sand	10	70
Gravel	70	82
Mud	82	460
Sand	460	500

WELL LOCATION:


sec. 9 T. 18 N R. 7 E
 NW 1/4 of Stonerille
 (distance) (direction) (nearest town)

WELL PURPOSE: Irrigation
 (home, irrigation, municipal, industrial)

WELL COMPLETION DATA:

- (1) diameter (inches) 4 X 3
- (2) total depth (feet) 500
- (3) static water level (feet) 29 below top of ground.
- (4) casing Black steel 470' (material) (depth)
4 X 3 (size) if telescope see back.
- (5) screen 30 470 (length) (depth to top)
3" stainless steel (size) (material)
- (6) pump 80 (HP) (yield gpm)
- (type power)
- (7) electric log No (yes or no)
- (organization running log)
- (8) how well bottom plugged Wash valve

DRILLERS REMARKS:

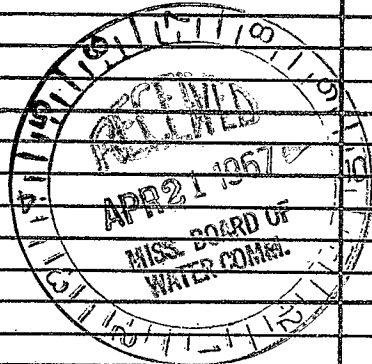

If well telescopes please sketch and show depths.


GROUND LEVEL

4"
147'

3"
323'

3"
screen
30'

If more than one screen,
show locations of each on sketch.

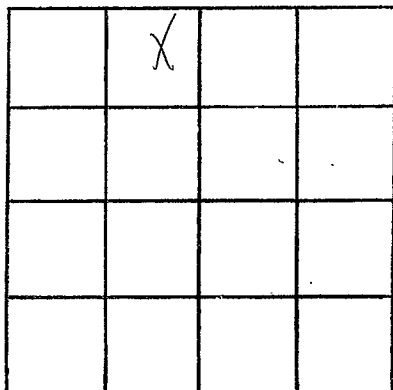

SECTION 9

Please indicate well location X.

ADDITIONAL INFORMATION

Multiple horizontal lines for additional information.