

CODED

EL65
6-28-63

WATER WELL DRILLERS LOG


Date: 6/28, 1963, Driller: Bailey Drilling Co. County: Washington
(Name)

(1) Owner of Land:	Description & Color of Materials Sand, Clay, Red Clay, Shell, etc.	Thick- ness Feet	Depth Feet
<u>Stanley Ingram</u> (Name) <u>Leland, Miss.</u> (Address)	<u>Clay</u>		<u>20</u>
(2) Location: <u>1/4, 1/4, Sec. 28^{18N} 7^W</u>	<u>Sand</u>		<u>80</u>
<u>4</u> miles <u>SW</u> of <u>Leland</u> (distance) (direction) (Nearest Town)	<u>Gravel</u>		<u>90</u>
(3) Topography: <u>Flat</u> (Hilly) (Flat) (Level)	<u>Mud</u>		<u>158</u>
(4) Purpose of Well: <u>domestic</u> (Domestic Irrigation Municipal, Industrial, Other)	<u>Sand</u>		<u>180</u>
	<u>Mud</u>		<u>391</u>
	<u>Mud & Sand</u>		<u>440</u>
	<u>Sand</u>		<u>450</u>
	<u>Rock</u>		<u>457</u>
	<u>Sand</u>		<u>481</u>

CODED

Information upon completion of well:

- (1) Diameter 2 1/2 X 2 inches.
- (2) Total Depth 481 feet.
- (3) Water Level 37 feet below top of ground.
- (4) Cased to all way Size 2 1/2 X 2
- (5) Screen: Size 2, Length 10ft.
- (6) Were any formations sealed against pollution?
yes, no.

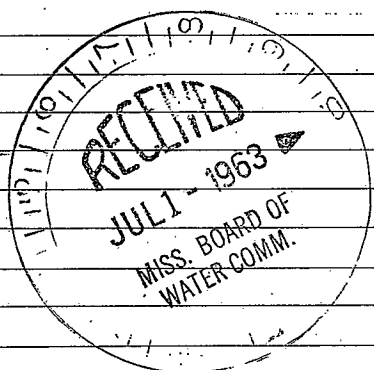

If YES depth of formation _____
Why _____

Drillers Remarks: _____

Well No.

(Use Back Side)

