

~~6~~ E66
4-19-63

WATER WELL DRILLERS LOG

CODED


Date: 4/19, 1963, Drillers: Bailey Drilling Co. County: Washington
(Name)

(1) Owner of Land: J. J. Bennett
(Name)
Leland, Miss.
(Address)
Wilmot 3 17N 7W
(2) Location: 1/4, 1/4, Sec. 10 T. R.
5 miles south, of Leland
(distance) (direction) (Nearest Town)
(3) Topography: Flat
(Hilly) (Flat) (Level)
(4) Purpose of Well: domestic
(Domestic Irrigation
Municipal, Industrial, Other)

Description & Color of Materials Sand, Clay, Red Clay, Shell, etc.	Thick- ness Feet	Depth Feet
<u>Clay</u>		<u>16</u>
<u>Sand</u>		<u>82</u>
<u>Gravel</u>		<u>148</u>
<u>Mud</u>		<u>153</u>
<u>Rock</u>		<u>154</u>
<u>Mud</u>		<u>390</u>
<u>Sand</u>		<u>430</u>

Information upon completion of well:

(1) Diameter 4x2 1/2 inches.
(2) Total Depth 430 feet.
(3) Water Level 25 feet below top of ground.
(4) Cased to all way Size 4x2 1/2
(5) Screen: Size 20 Length 20 ft
2 1/2
(6) Were any formations sealed against pollution?
X yes, X no.

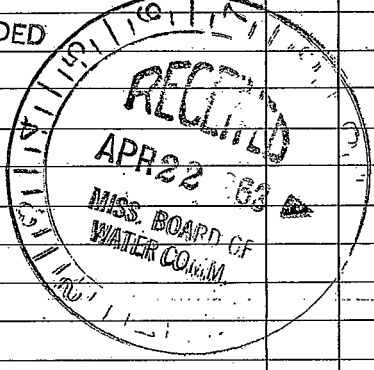

If YES depth of formation _____
Why _____
Drillers' Remarks: _____

(Use Back Side)

Well No.

1. The first part of the document discusses the importance of maintaining accurate records of all transactions. It emphasizes that this is crucial for the company's financial health and for providing reliable information to stakeholders.

2. The second part of the document outlines the specific procedures for recording transactions. It details the steps from identifying a transaction to entering it into the accounting system, ensuring that all necessary details are captured.

3. The third part of the document addresses the role of the accounting department in monitoring and controlling the company's financial performance. It discusses how regular reviews and audits can help identify areas for improvement and prevent potential issues.

4. The fourth part of the document provides a summary of the key points discussed and offers recommendations for further action. It encourages the company to continue to refine its financial reporting processes to ensure the highest level of accuracy and transparency.