

Washington
E 67
8-21-69

MISSISSIPPI
BOARD OF WATER COMMISSIONERS
416 North State Street
Jackson, Mississippi 39201

WATER WELL DRILLERS LOG

Aug 21 1969 Schultz Drilling Washington
date well completed firm name county well located

LANDOWNER: Fred Taylor
RT 1
Pelena, Miss
(mailing address)

WELL LOCATION:
sec. 30 T. 18 N R. 7 E
3 1/2 miles ESE of GREENVILLE
(distance) (direction) (nearest town)

WELL PURPOSE: stone
(home, irrigation, municipal, industrial)

- WELL COMPLETION DATA:
- (1) diameter (inches) 2"
 - (2) total depth (feet) 446
 - (3) static water level (feet) 40 below top of ground.
 - (4) casing Ash (material), (depth),
10 (size) if telescope see back.
 - (5) screen 5 (length), (depth to top)
2" (size), 5" (material)
 - (6) pump 1 (HP), 12 (yield gpm)
Elec (type power)
 - (7) electric log No (yes or no)
(organization running log)
 - (8) how well bottom plugged


description of formations encountered	from	to
Clay	0	19
sand	19	83
blue clay	83	141
sandy shale	141	180
shale & clay	180	302
Rock's	302	304
sandy shale	304	363
sand	363	452

DRILLERS REMARKS:

AUG 25 1969
MISSISSIPPI BOARD OF WATER COMMISSIONERS

If well telescopes please sketch and show depths.

GROUND LEVEL

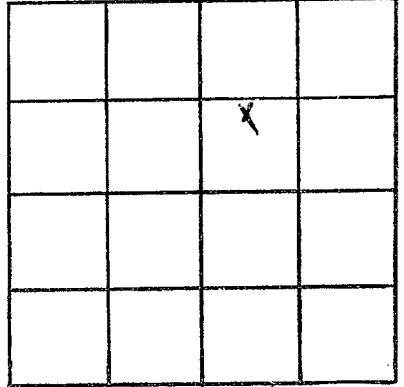

SECTION 30

Please indicate well location X.

ADDITIONAL INFORMATION

If more than one screen,
show locations of each on sketch.