

ELC

9-29-65

WATER WELL DRILLERS LOG

CODED

Date: 9/29, 1965, Driller: Bailey Drlg Co County: Washington

(1) Owner of Land: Walnut Payon Plant
 (Name)
Leland, Miss.
 (Address)
2 18N7W
 (2) Location: $\frac{1}{4}$, $\frac{1}{4}$, Sec. 2 T R
2 miles NW of Elizabeth
 (distance) (direction) (Nearest Town)
 (3) Topography: Flat
 (Hilly) (Flat) (Level)
 (4) Purpose of Well: Domestic
 (Domestic Irrigation
 Municipal, Industrial, Other)

Description & Color of Materials Sand, Clay, Red Clay, Shell, etc.	Thick- ness Feet	Depth Feet
Clay		20
Soft		60
Gravel		94


Information upon completion of well:

(1) Diameter 4 x 2 1/2 inches.
 (2) Total Depth 94 feet.
 (3) Water Level 22 feet below top of ground.
 (4) Cased to all way Size 4 x 2 1/2
 (5) Screen: Size 2 1/2, Length 10 ft.
 (6) Were any formations sealed against pollution?
 _____ yes, X no.

Insuff. info to locate

CODED

If YES depth of formation _____
 Why _____
 Drillers Remarks: _____

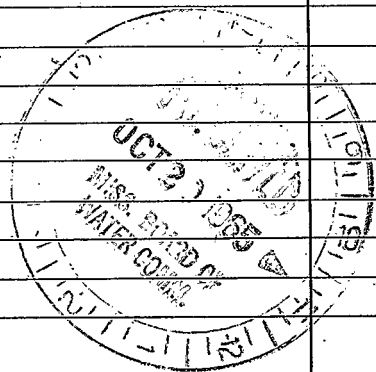

(Use Back Side)

Well No.

[The page contains extremely faint and illegible text, likely bleed-through from the reverse side of the document. No specific content can be transcribed.]