

WASHINGTON

E 69

12-16-68

CODED

MISSISSIPPI BOARD OF WATER COMMISSIONERS
416 North State Street
Jackson, Mississippi 39201

WATER WELL DRILLERS LOG

12-16
date well completed

1968 DYER WELL TRR.
firm name

WASHINGTON
county well located

LANDOWNER:

W. J. ABSHIRE
R.R. GREENVILLE, Miss.
(mailing address)

description of formations encountered

from to

CLAY	0	6
SAND	6	101
SANDY SHALE	101	125
SANDY SHALE	125	181
CLAY	181	290
SANDY CLAY	290	335
CLAY	335	365
ROCK	365	365
SANDY SHALE	365	382
ROCK	382	383
Gummy SHALE	383	452
ROCK	452	453
Gummy SHALE	453	471
SAND	471	491
CLAY SAND	491	539
SAND	539	562
SAND CLAY	562	565

WELL LOCATION:

sec. 20 T 18 N R 7 E
W
2 miles WEST of LELAND
(distance) (direction) (nearest town)

WELL PURPOSE:

IND. (home, irrigation, municipal, industrial)

WELL COMPLETION DATA:

- (1) diameter (inches) 4" x 2 1/2"
- (2) total depth (feet) 565'
- (3) static water level (feet) 26' below above top of ground. 4" B.C. 168'
- (4) casing 2 1/2" B.C. 377' (material) (depth)
- (size) If telescope see back.
- (5) screen 20' 545' (length) (depth to top)
2 1/2" STAINLESS STEEL (size) (material)
- (6) pump 3 70 (HP) (yield gpm)
ELEC. (type power)
- (7) electric log No (yes or no)

(organization running log)

(8) how well bottom plugged VALVE

FEB 17 1969
FEB 17


MISS. BD. OF
WATER COMM.

DRILLERS REMARKS:

If well telescopes please sketch and show depths.

GROUND LEVEL

*Connected with
sandy & gravel
no log pipe.*

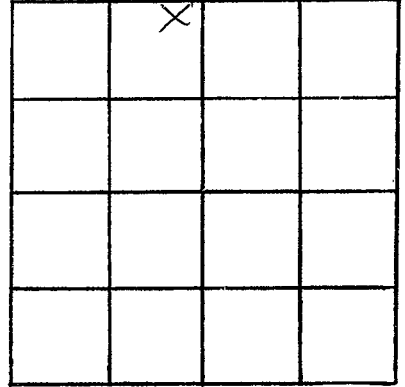

SECTION 20

Please indicate well location X.

ADDITIONAL INFORMATION

If more than one screen,
show locations of each on sketch.