

Washington  
E 71  
3-26-69

MISSISSIPPI  
BOARD OF WATER COMMISSIONERS  
416 North State Street  
Jackson, Mississippi 39201

CODED

WATER WELL DRILLERS LOG

26 mar 69. 19 date well completed  
H.W. Prompt Wash. firm name  
Wash. county well located

LANDOWNER:	description of formations encountered	from	to
Joe Nickols			
Airport Rd. (mailing address)	Clay	0	15
WELL LOCATION:	Sand	15	60
sec. 14 T. 18 N R. 7 W	Sand & gravel	60	95
3 miles E of Greenville	blue clay	95	165
(distance) (direction) (nearest town)	<del>Rock</del> Sand	165	185
WELL PURPOSE: home.	Rock	185	185 1/2
(home, irrigation, municipal, industrial)	Clay & Sand strip	185 1/2	285
WELL COMPLETION DATA:	Clay	285	305
(1) diameter (inches) 2"	Sand & Clay strip	305	325
(2) total depth (feet) 435'	Sand	325	366
(3) static water level (feet) 24 (below top of ground)	Rock	366	367
(4) casing galv. 425' (material) (depth)	sand.	367	375
(size) If telescope see back.	Rock	375	376
(5) screen 10' 435' (length) (depth to top)	sand.	376	440
2" S.S. (size) (material)			
(6) pump 1 1300 (HP) (yield gpm)			
Elect (type power)			
(7) electric log (yes or no)			
(organization running log)			
(8) how well bottom plugged backwash valve.			
DRILLERS REMARKS:			


CODED

APR 14 1969

MISS. DEPT. OF WATER RESOURCES

If well telescopes please sketch and show depths.

GROUND LEVEL

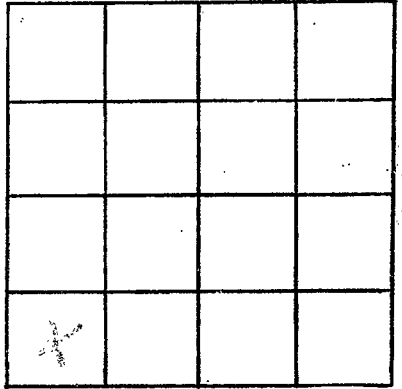

SECTION 17

Please indicate well location X.

ADDITIONAL INFORMATION

If more than one screen, show locations of each on sketch.