

WASHINGTON
E 76
8-20-70

MISSISSIPPI
BOARD OF WATER COMMISSIONERS
416 North State Street
Jackson, Mississippi 39201

CODED

WATER WELL DRILLERS LOG

20 Aug. 1970 Little Pump & Water Well Serv Wash
date well completed firm name county well located

LANDOWNER: T. Hester
146 Lester Dr.
Greenville Miss.
(mailing address)

WELL LOCATION:
sec. 18 T. 18 N R. 7 W
4 miles E of Greenville
(distance) (direction) (nearest town)

WELL PURPOSE: home
(home, irrigation, municipal, industrial)

WELL COMPLETION DATA:

- (1) diameter (inches) 4x2
- (2) total depth (feet) 356
- (3) static water level (feet) 46 below top of ground.
- (4) casing 90/2, 356
(material) (depth)
4x2 if telescope see back.
(size)
- (5) screen 20 ft, 356
(length) (depth to top)
2", SS.
(size) (material)
- (6) pump 1, 20
(HP) (yield gpm)
Elect.
(type power)
- (7) electric log _____
(yes or no)

(organization running log)
- (8) how well bottom plugged Steel plug

description of formations encountered	from	to
Clay	0	45
Sand	45	60
Sand & fine gravel	60	87
Clay blue	87	190
Sand & Clay st.	190	260
Sand	260	283
Rock	283	284
Sand	284	298
Rock	298	299
Sand good.	299	360

CODED

AUG 26 1970

DRILLERS REMARKS:

MISS. BD. OF
WATER COMM.


If well telescopes please sketch and show depths.

GROUND LEVEL

126 4"

210' 2"

2" ROSE
55.0

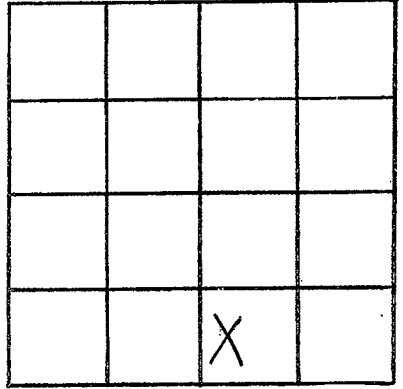

SECTION 18

Please indicate well location X.

ADDITIONAL INFORMATION

If more than one screen, show locations of each on sketch.