

WASHINGTON  
E 77  
2-22-71

MISSISSIPPI  
BOARD OF WATER COMMISSIONERS  
416 North State Street  
Jackson, Mississippi 39201

**CODED**

WATER WELL DRILLERS LOG

2/22 1971 Bailey Drlg Co. Washington  
date well completed firm name county well located

LANDOWNER: Perrin Grissom  
Leland, Miss.  
(mailing address)

Description of formations encountered	from	to
Clay	0	20
Sand	20	70
Gravel	70	90
Mud	90	360
Sand	360	484

WELL LOCATION:  
sec. 5 T. 18 N. R. 7 E  
4 miles W of Leland  
(distance) (direction) (nearest town)

WELL PURPOSE: Farm  
(home, irrigation, municipal, industrial)

- WELL COMPLETION DATA:
- (1) diameter (inches) 4x2
  - (2) total depth (feet) 484
  - (3) static water level (feet) 50 below top of ground.
  - (4) casing Steel, 464,  
(material) (depth)  
4x2 if telescope see back.  
(size)
  - (5) screen 20', 464  
(length) (depth to top)  
2", stainless steel  
(size) (material)
  - (6) pump 2 30  
(HP) (yield gpm)  
Elec  
(type power)
  - (7) electric log No.  
(yes or no)

**CODED**

(organization running log)

FEB 24 1971

(8) how well bottom plugged:  
Back pressure valve

DRILLERS REMARKS:

MISC. PD. OF  
WATER


If well telescopes please sketch and show depths.

GROUND LEVEL

147 ft 11"

51 ft 2"

soft timber

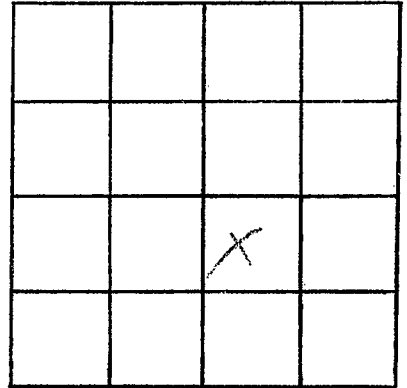

SECTION 5

Please indicate well location X.

ADDITIONAL INFORMATION

If more than one screen, show locations of each on sketch.