

ELOG# 73

CODED

WASH.
E 79
1-31-72

MISSISSIPPI
BOARD OF WATER COMMISSIONERS
416 North State Street
Jackson, Mississippi 39201

FEB 14 1972

WATER WELL DRILLERS LOG

MISS. Bd. OF
WATER COMMISSIONERS
Washington
county well located


1-31 1972 Schultz Drilling
date well completed firm name

LANDOWNER:	description of formations encountered	from	to
Oliver Pope			
Beland, Miss (mailing address)	Clay	0	15
	Sand	15	115
WELL LOCATION: sec. 12 T. 18 N R. 7 E 1 miles North of Beland (distance) (direction) (nearest town)	Clay	115	191
	Sandy Shale	191	250
WELL PURPOSE: Industrial (home, irrigation, municipal, industrial)	Sand	250	264
WELL COMPLETION DATA:	Sand + Shale Shale	264	466
(1) diameter (inches) 6 x 4"	Sand	466	529
(2) total depth (feet) 496			
(3) static water level (feet) 26 below top of ground.			
(4) casing steel (material), (depth)			
6 x 4 (size) if telescope see back.			
(5) screen 30 (length), (depth to top)			
4" (size), Stainless (material)			
(6) pump 15 (HP) 150 gpm @ 90 psi (yield/gpm)			
Electric (type power)			
(7) electric log yes (state) (yes or no)			
(organization running log)			
(8) how well bottom plugged			
DRILLERS REMARKS:			

CODED

If well telescopes please sketch and show depths.

GROUND LEVEL

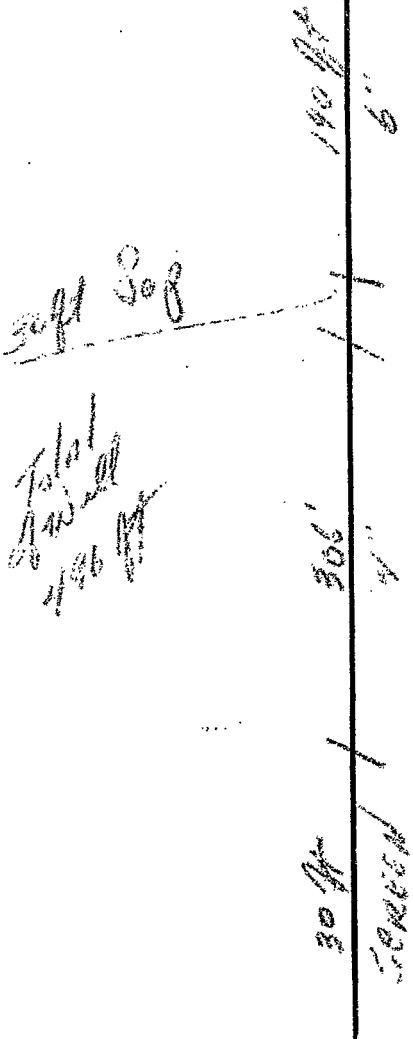

			X

SECTION 12

Please indicate well location X.

ADDITIONAL INFORMATION

If more than one screen, show locations of each on sketch.