

WASHINGTON
E 80
10-11-71

MISSISSIPPI
BOARD OF WATER COMMISSIONERS
416 North State Street
Jackson, Mississippi 39201

FEB 14 1972

WATER WELL DRILLERS LOG

MISS. BD. OF
WATER COM.

10-18

1971

Schultz Drilling Co

Washington

date well completed

firm name

county well located

LANDOWNER: Miss. State University

description of formation encountered

from

to

Stonerville, Miss
(mailing address)

Clay

0 17

Sand

17 90

WELL LOCATION:

sec. 7 T. 18 N R. 2 E
1 miles N-W of Stonerville
(distance) (direction) (nearest town)

WELL PURPOSE:

(home, irrigation, municipal, industrial)

WELL COMPLETION DATA:

- (1) diameter (inches) 2"
(2) total depth (feet) 95
(3) static water level (feet) 17 below top of ground.
(4) casing Plastic (material) (depth)

(size) if telescope see back.

- (5) screen 5 (length) (depth to top)

2" (size) Plastic (material)

- (6) pump 1 (HP) 25 (yield gpm)

File (type power)

- (7) electric log no (yes or no)

(organization running log) ✓

- (8) how well bottom plugged Pop


DRILLERS REMARKS:

CODED

CODED

If well telescopes please sketch and show depths.

GROUND LEVEL

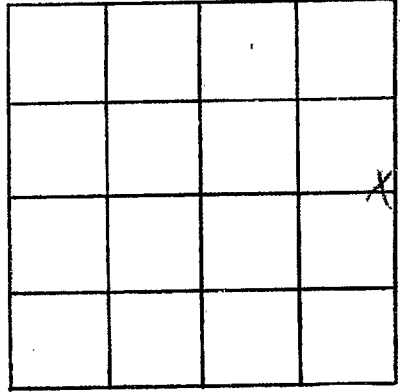

SECTION 4

Please indicate well location X.

ADDITIONAL INFORMATION

If more than one screen,
show locations of each on sketch.