

WASHINGTON  
E 81  
6-2-72

MISSISSIPPI  
BOARD OF WATER COMMISSIONERS  
416 North State Street  
Jackson, Mississippi 39201

**CODED**

WATER WELL DRILLERS LOG

6/2 1972 Schultz Drilling Washington  
date well completed firm name county well located

LANDOWNER: <u>Ray Kuhd</u>	description of formations encountered	from	to
<u>Deland Miss</u> (mailing address)			
	<u>sand</u>	<u>21</u>	<u>90</u>

WELL LOCATION:  
sec 29 T 19 N R 7 E  
2 miles S-W of Deland  
(distance) (direction) (nearest town)

WELL PURPOSE: dr  
(home, irrigation, municipal, industrial)

- WELL COMPLETION DATA:
- (1) diameter (inches) 2'
  - (2) total depth (feet) 90
  - (3) static water level (feet) 18 below top of ground.
  - (4) casing Plastic  
(material) (depth)
  - (size) If telescope see back.
  - (5) screen 20  
(length) (depth to top)  
2" Plastic  
(size) (material)
  - (6) pump 3 70  
(HP) (yield gpm)  
Ela  
(type power)
  - (7) electric log no  
(yes or no)
  - (organization running log)
  - (8) how well bottom plugged plug

**CODED**


UGT 12 1972

MISS. RD. OF  
WATER COMM.

DRILLERS REMARKS:

If well telescopes please sketch and show depths.

GROUND LEVEL

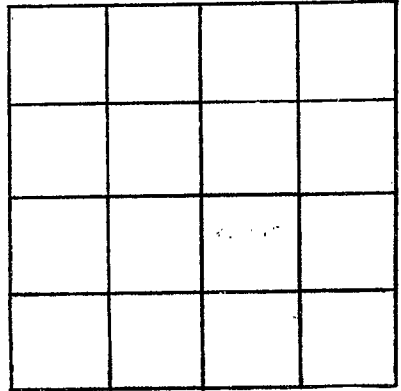

SECTION \_\_\_\_\_

Please indicate well location X.

ADDITIONAL INFORMATION

If more than one screen,  
show locations of each on sketch.