

WASHINGTON
E83
5-28-73

MISSISSIPPI
BOARD OF WATER COMMISSIONERS
416 North State Street
Jackson, Mississippi 39201

CODED

WATER WELL DRILLERS LOG

5-28 1973 date well completed
DYER WELL & IRRIGATION SERVICE firm name
WASHINGTON county well located

LANDOWNER: ~~WARREN HAMMETT~~
WARREN HAMMETT

description of formations encountered

GREENVILLE, MISS
(mailing address)

description of formations encountered	from	to
CLAY	0	30
Fine SAND	30	45
SAND GRAVEL	45	87

WELL LOCATION:
sec. 19 T 18 N R 7 E
3 miles W of LELAND
(distance) (direction) (nearest town)

WELL PURPOSE: IRR.
(home, irrigation, municipal, industrial)

WELL COMPLETION DATA:

- diameter (inches) 16"
- total depth (feet) 87
- static water level (feet) 7' below top of ground.
- casing BULK IN, 47' (material), (depth)
16" (size) If telescope see back.
- screen 40', 47' (length), (depth to top)
16", BULK IN BOT (size), (material)
- pump 60 (HP), 1500 (yield gpm)
DIESEL (type power)
- electric log 110 (yes or no)
(organization running log)
- how well bottom plugged PLATE


CODED

DRILLERS REMARKS:

JUN 27 1973

If well telescopes please sketch and show depths.

GROUND LEVEL

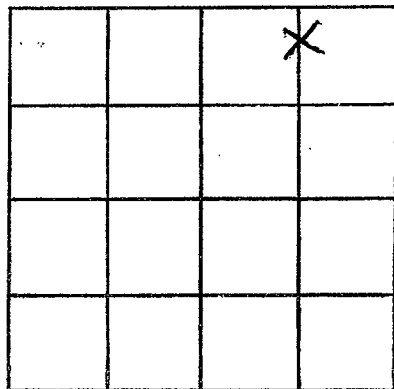

SECTION 19

Please indicate well location X.

ADDITIONAL INFORMATION

If more than one screen, show locations of each on sketch.